


T.14S.R.5W.W.M.

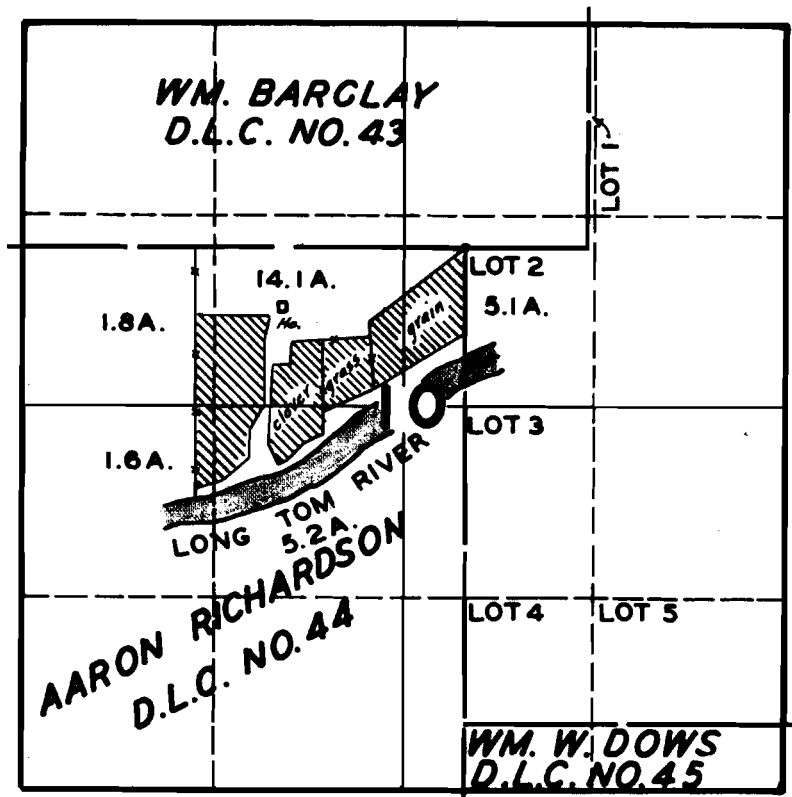

FINAL PROOF SURVEY UNDER

Application No. 18322... Permit No. 13956...
IN NAME OF

CHARLES C. COLEGROVE

Surveyed JULY 15, 1948, by JAS. E. BUNNELL