


T.17S.R.12W.W.M.

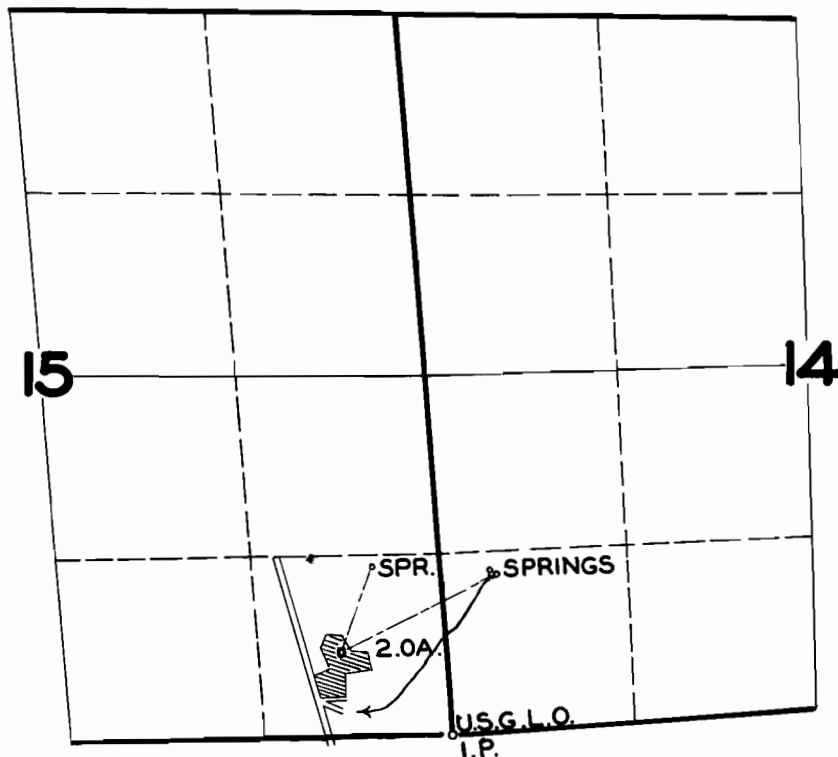

FINAL PROOF SURVEY
UNDER

Application No. **18417** Permit No. **14051**
IN NAME OF

F.E. WESTON & MARY RUSTAD WESTON

Surveyed **JUL. 28, 1948**, by **JAS. E. BUNNELL**