


T.5S.R.3W.W.M.

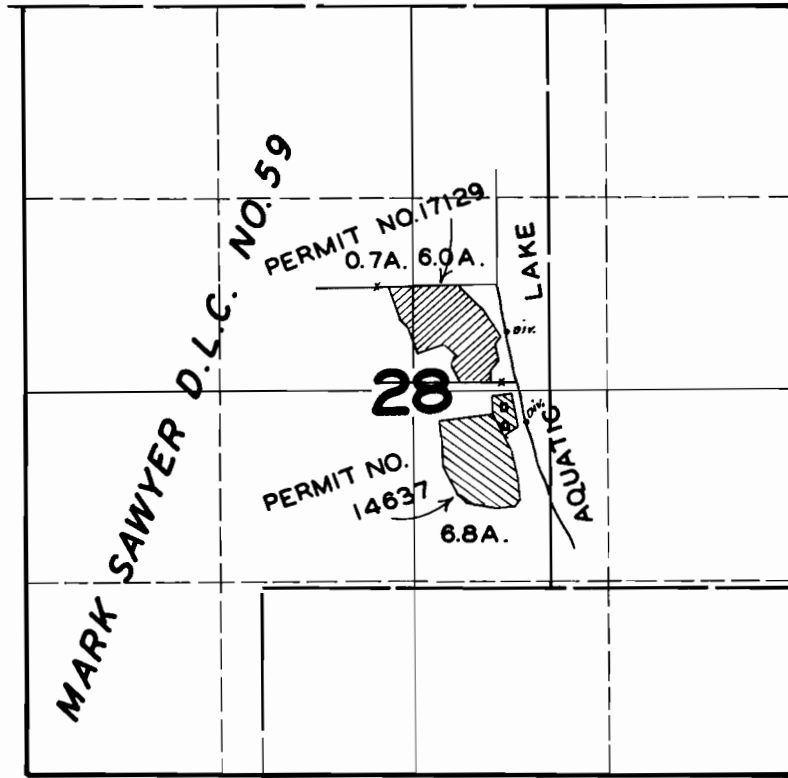

FINAL PROOF SURVEY

UNDER

19031 14637
Application No. 21774 Permit No. 17129

IN NAME OF

FRED BAUER

Surveyed JUN. 24 1947, by JAS. E. BUNNELL