


T.4S.R.4W.W.M.

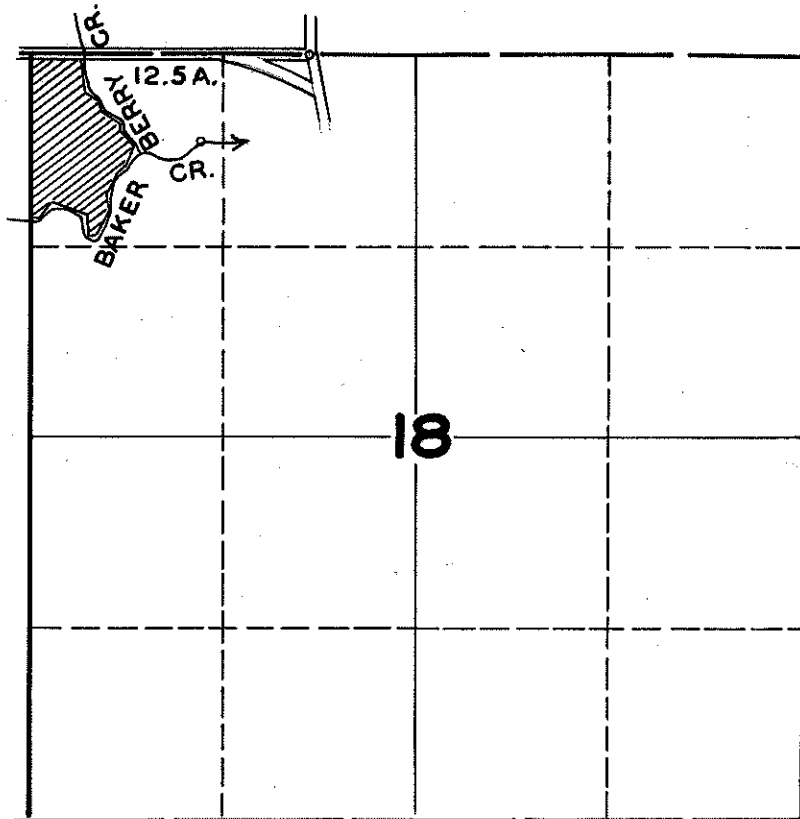

FINAL PROOF SURVEY UNDER

Application No. 19010 Permit No. 14622
IN NAME OF

JOHN G. & ETHEL MANNING

Surveyed SEP. 8 1948, by JAS. E. BUNNELL