


T.4S.R.2E.W.M.

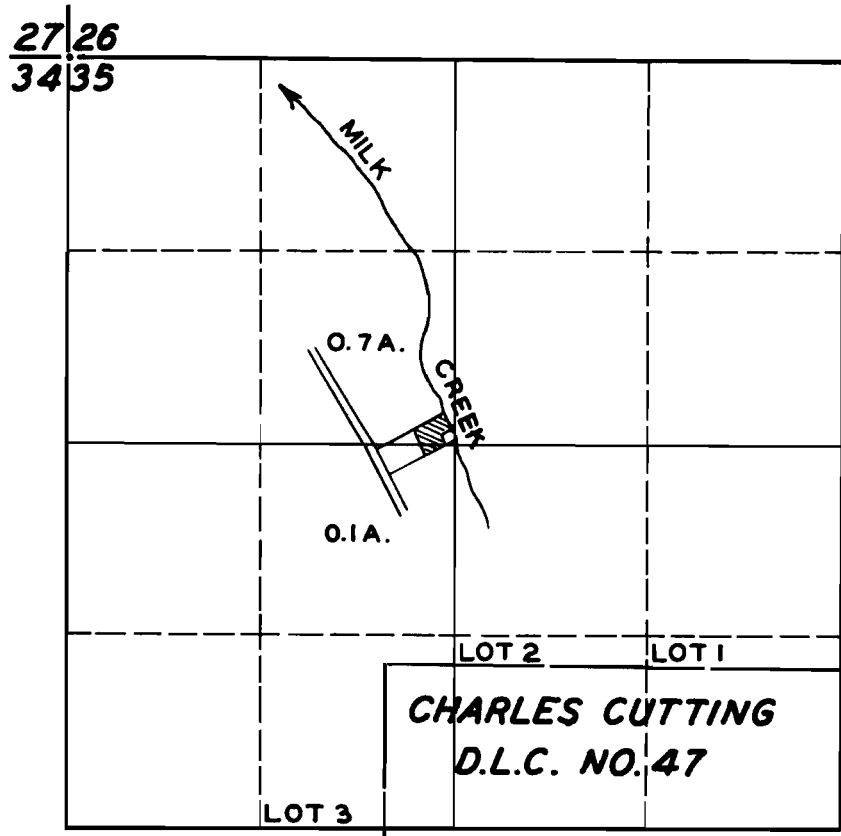

FINAL PROOF SURVEY
UNDER

Application No. 19180 Permit No. 14777
IN NAME OF

LOYAL D. WALKER

Surveyed APR. 30 1948, by JAS. E. BUNNELL