


T.13S. R. 27E. W.M.

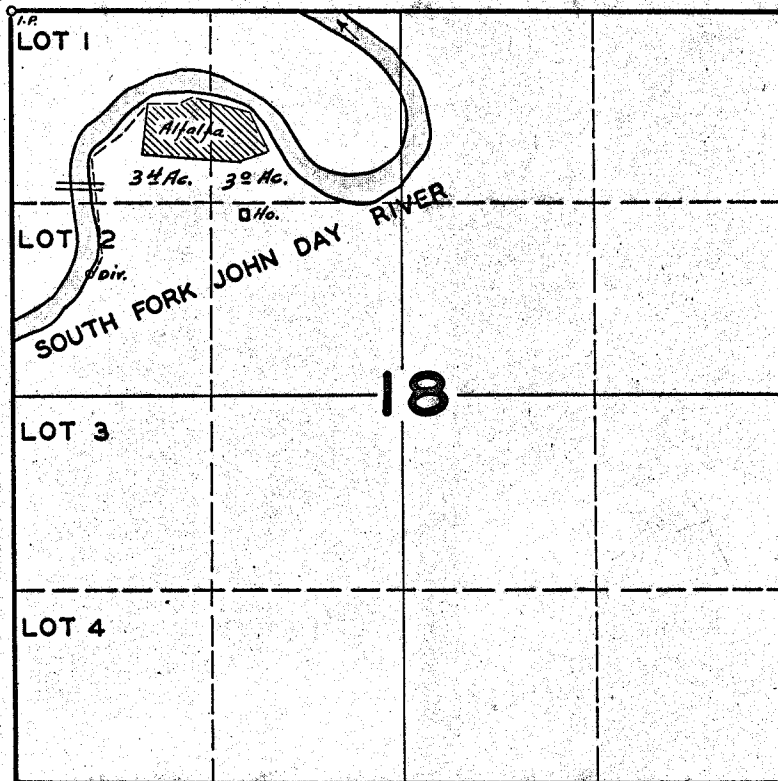

FINAL PROOF SURVEY UNDER

Application No. 19573 Permit No. 15155

IN NAME OF

GUSTAVE & GERTRUDE F. ROBERTSON

Surveyed APR. 27 1947, by JAS. E. BUNNELL