


T.14S.R.8W.W.M.

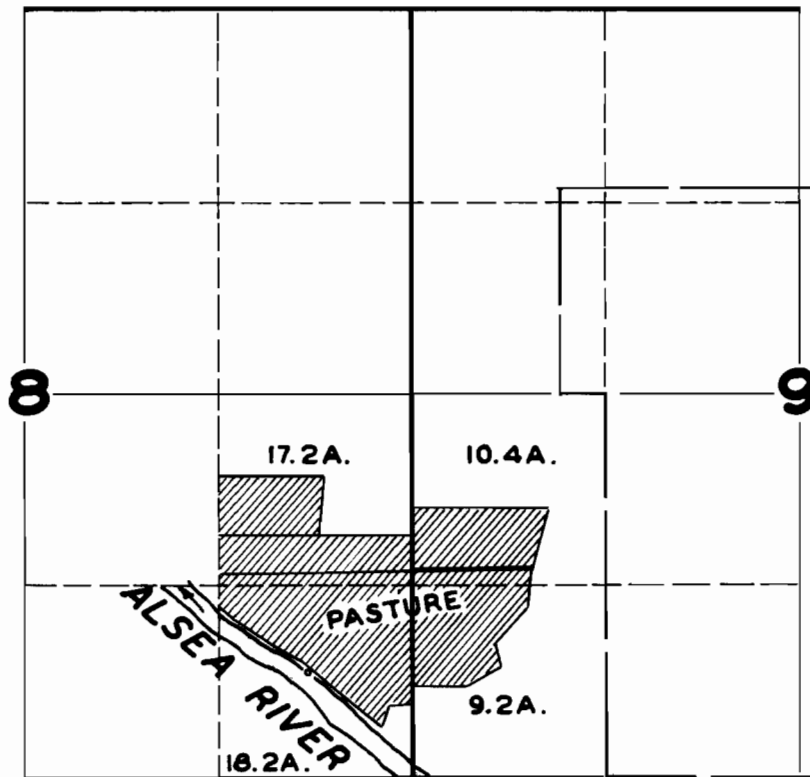

FINAL PROOF SURVEY

UNDER

Application No. **19313** Permit No. **14896**

IN NAME OF

WE, CHAS. W. MALTBY & MAE MC KINNIS

Surveyed **APR. 12, 1949**, by **JAS. E. BUNNELL**