


T.17S.R.2W.W.M.

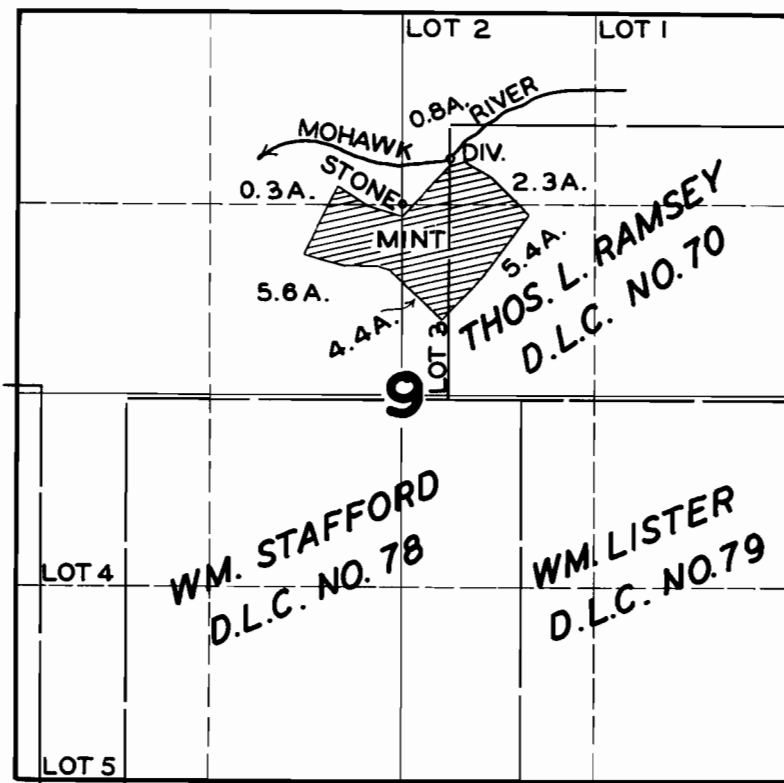

FINAL PROOF SURVEY UNDER

Application No. 19731..... Permit No. 15301.....
IN NAME OF

PETE HANSEN

Surveyed JUNE 23 1948, by JAS. E. BUNNELL