


T. 8 S. R. 5 W. W. M.

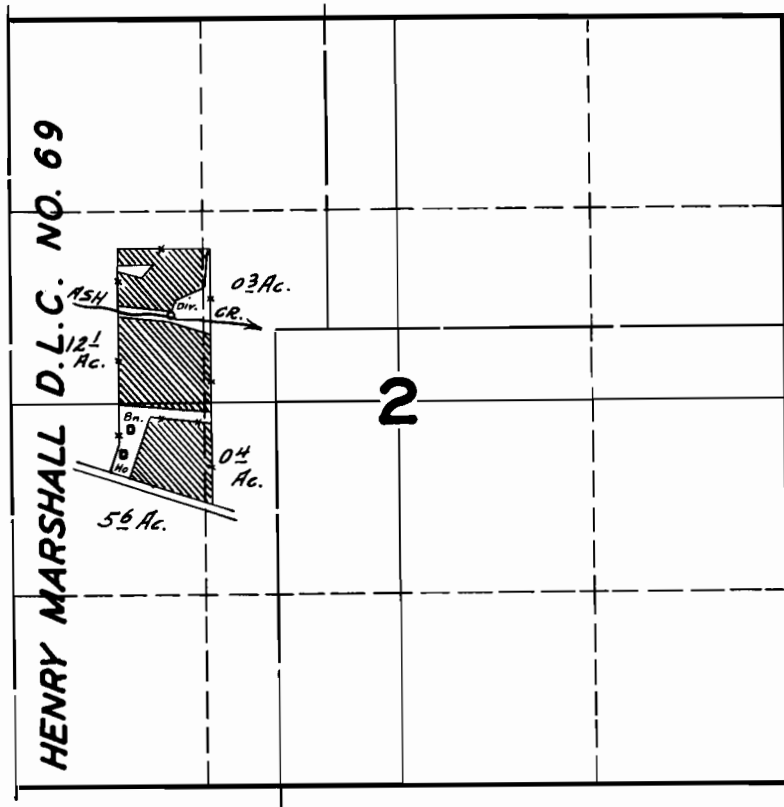

FINAL PROOF SURVEY UNDER

Application No. **19950** Permit No. **15526**

IN NAME OF

DAVID D. GIESBRECHT

Surveyed **SEP. 15, 1947**, by **JAS. E. BUNNELL**