


T.4S.R.3W.W.M.

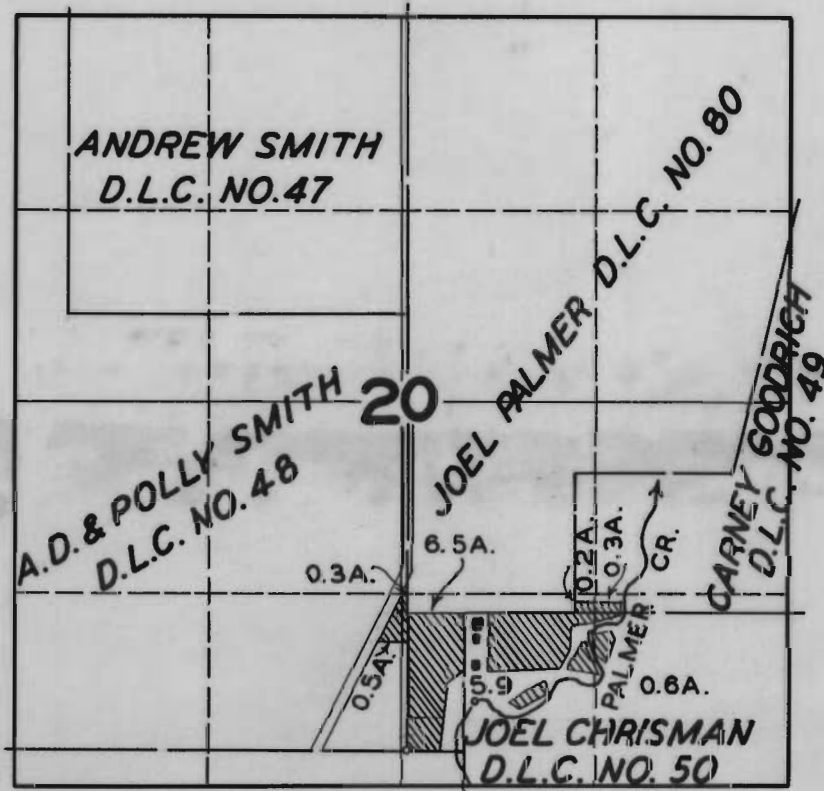

FINAL PROOF SURVEY

UNDER

Application No. **20811** Permit No. **16286**

IN NAME OF

H. G. LYON

Surveyed **JUNE 8, 1948**, by **JAS. E. BUNNELL**