


T.6S.R.1W.W.M.

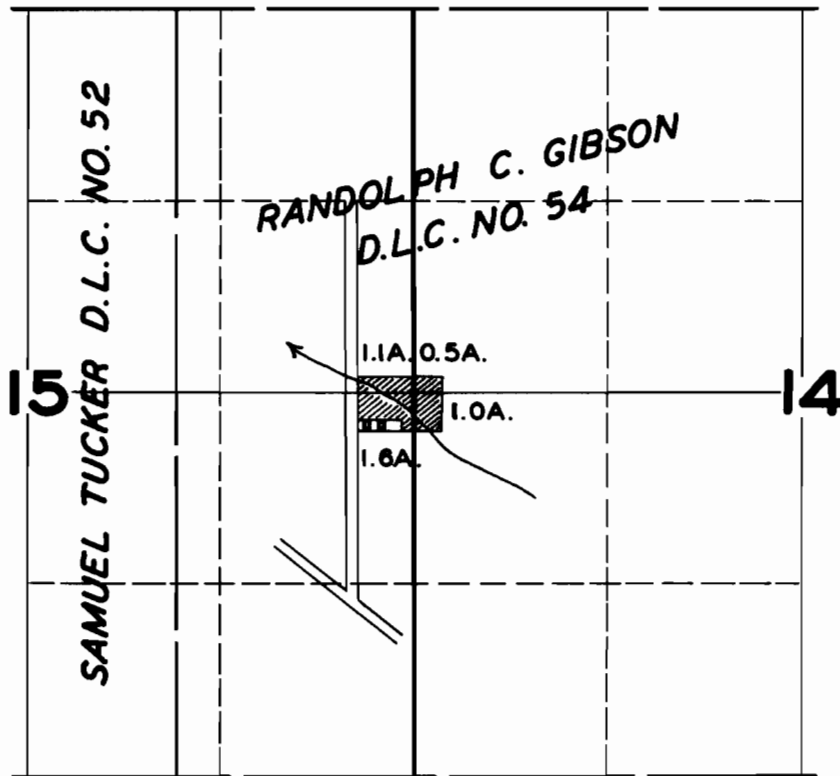

FINAL PROOF SURVEY

UNDER

Application No. 20650.. Permit No. 16316.....

IN NAME OF

LAWRENCE J. & CECILIA ANN WURDINGER

Surveyed APR. 22 1948, by JAS. E. BUNNELL