


T.6S.R.2W.W.M.

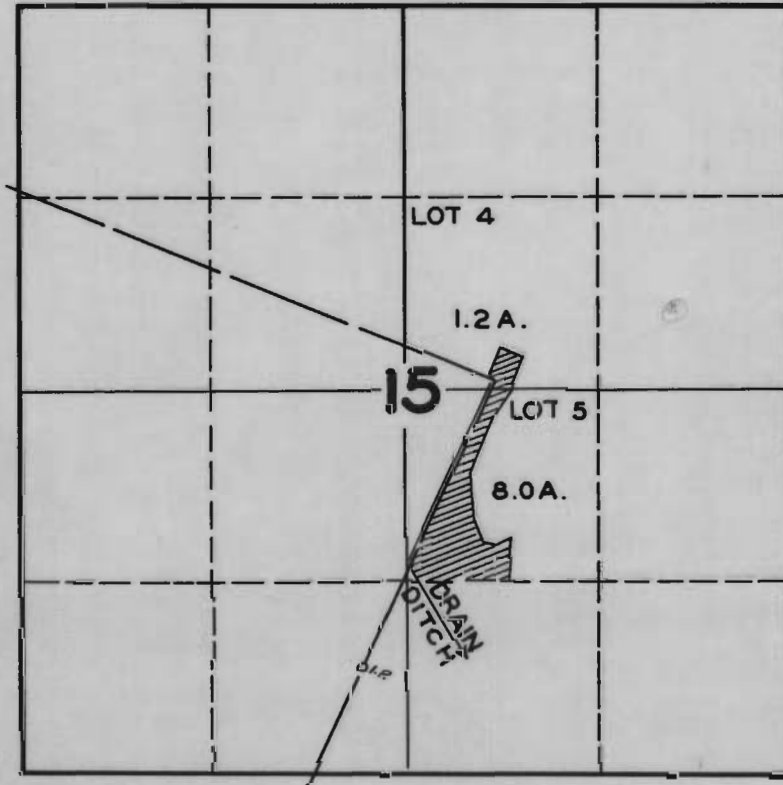

**FINAL PROOF SURVEY
UNDER**

Application No. 20820 Permit No. 16324

IN NAME OF

MRS. ARETA V. HARPER

Surveyed APR. 15 1947, by JAS. E. BUNNELL