


T.20S. R.3W.W.M.

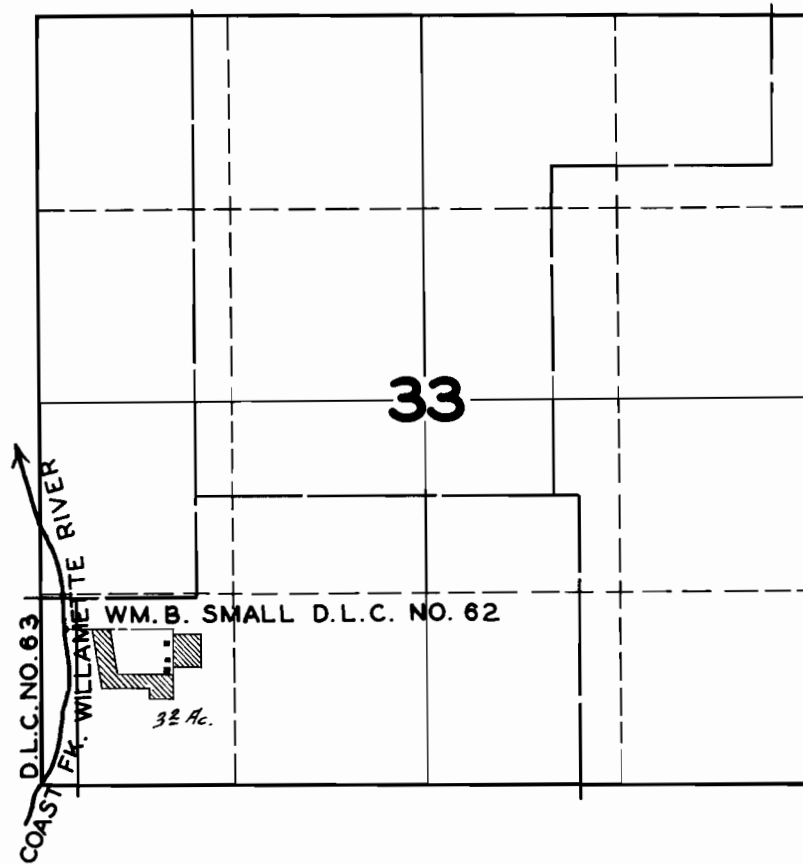

FINAL PROOF SURVEY

UNDER

Application No. 21035 Permit No. 16454

IN NAME OF

HARRY L. BREWSTER & LETHA BREWSTER - HUSBAND & WIFE

Surveyed AUG. 7 1947, by JAS. E. BUNNELL