


**T.19S.R.6W.W.M.**

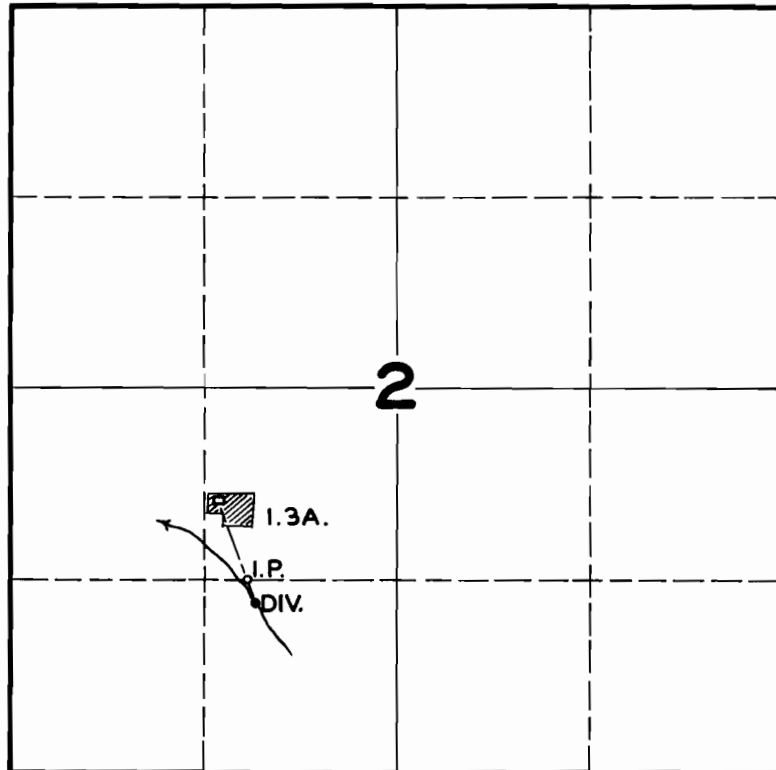

**FINAL PROOF SURVEY**  
UNDER

Application No. **21051** Permit No. **16496**  
IN NAME OF

**MILTON C. MAIN**

Surveyed **JUNE 21 1948**, by **JAS. E. BUNNELL**