


# T. 15. R. 4 W. W. M.

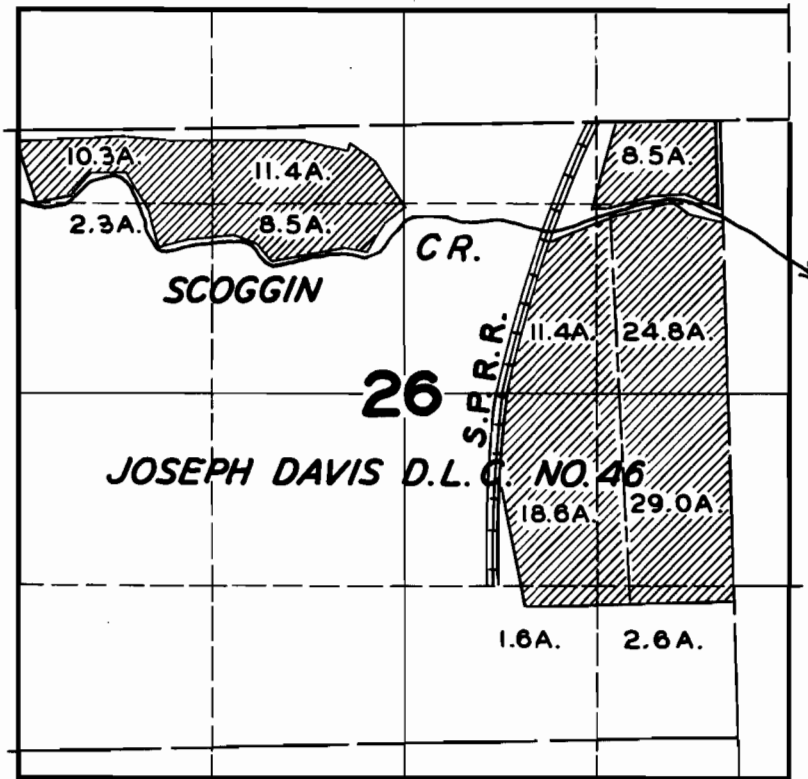

## FINAL PROOF SURVEY UNDER

Application No. 21256... Permit No. 16658...  
IN NAME OF

..... SHADY BEARD .....

Surveyed MAY 19, 1948, by JAS. E. BUNNELL