


└

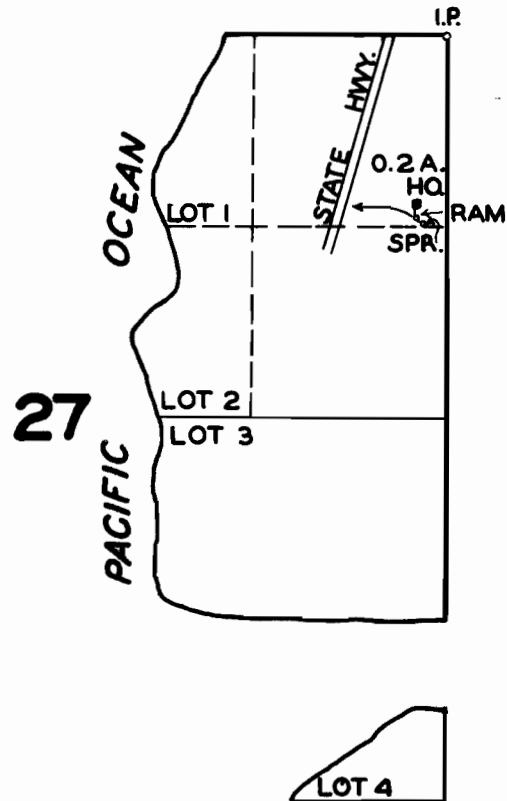

L

ROSS H. LINNVILLE

1948-E