


T.2S.R.4W.W.M.

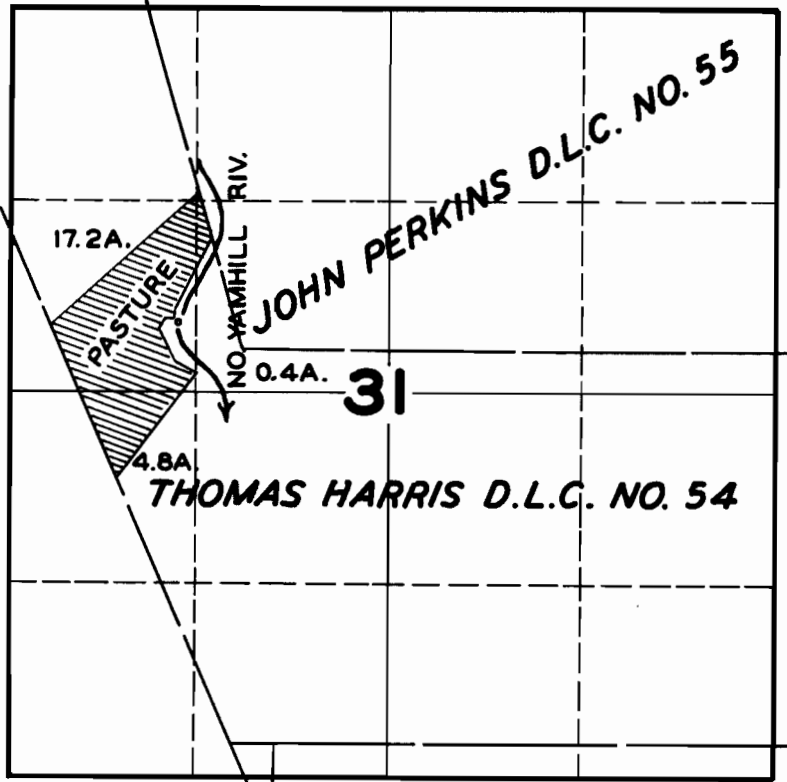

FINAL PROOF SURVEY
UNDER

Application No. **21602** Permit No. **16971**
IN NAME OF

VIRGIL DONALDSON

Surveyed **OCT. 8, 1948**, by **JAS. E. BUNNELL**