


T.2S.R.1E.W.M.

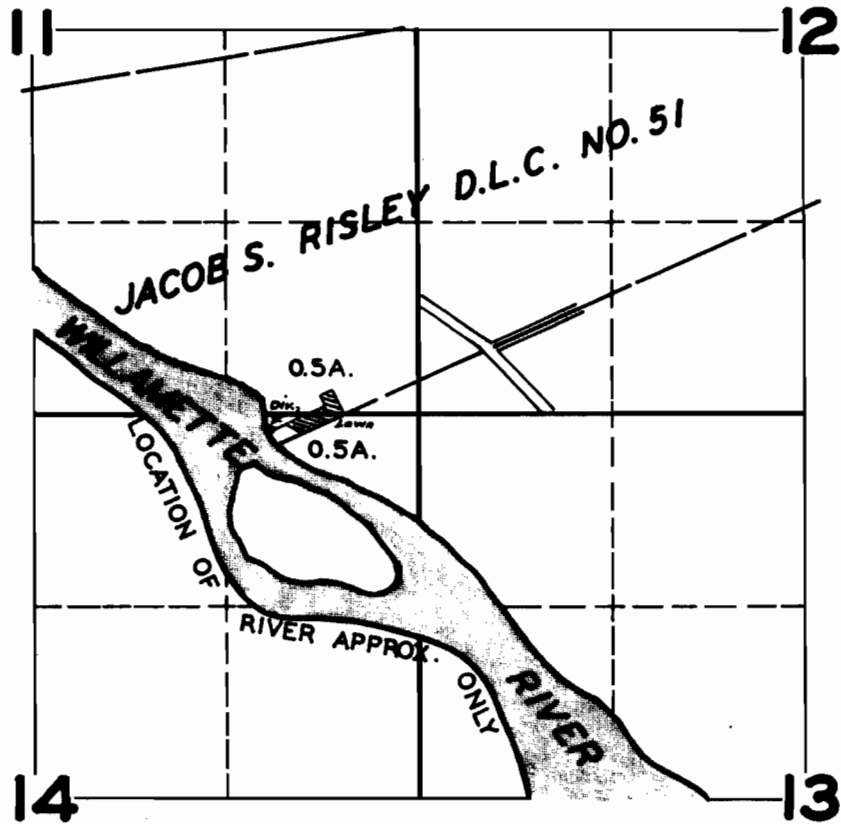

**FINAL PROOF SURVEY
UNDER**

Application No. 21670 Permit No. 17018

IN NAME OF

ADOLPH HABLUETZEL

Surveyed JUN. 20 1947, by JAS. E. BUNNELL