


T.5S.R.3W.W.M.

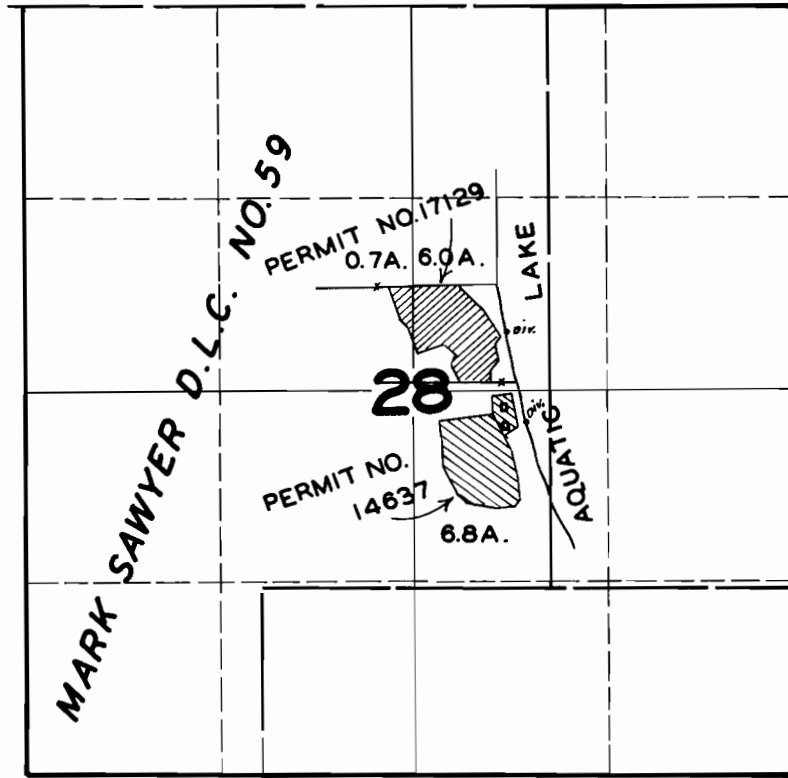

FINAL PROOF SURVEY

UNDER

Application No. **19031** .. **14637**
21774 .. Permit No. **17129** ..

IN NAME OF

FRED BAUER

Surveyed **JUN. 24 1947**, by **JAS. E. BUNNELL**