


T.I.S.R.I.E.W.M.

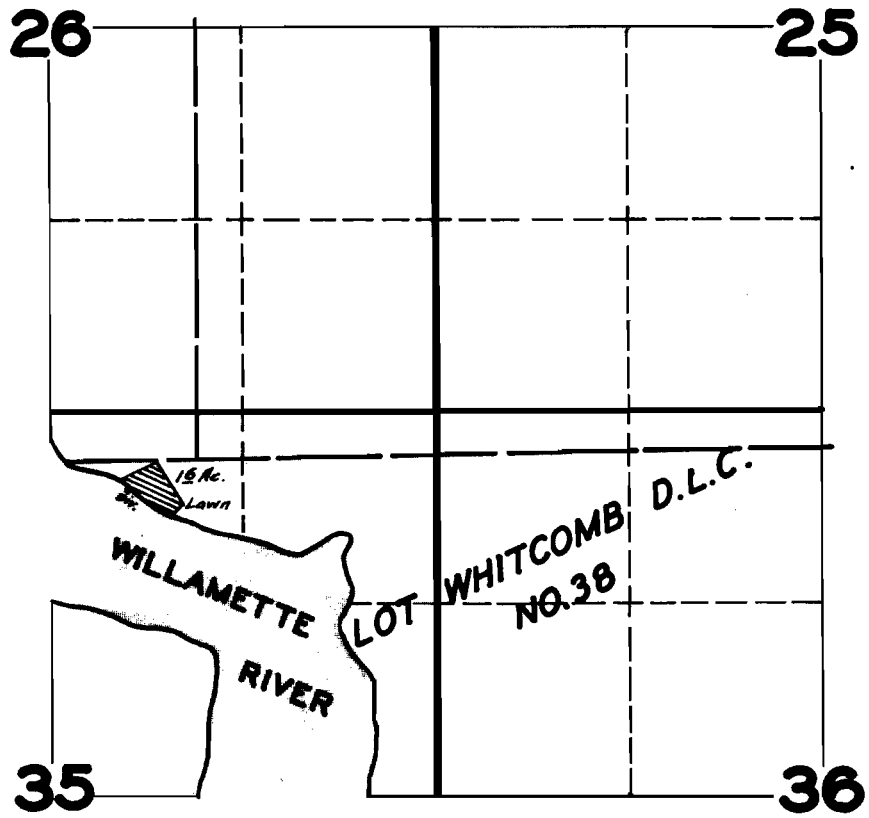

**FINAL PROOF SURVEY
UNDER**

Application No. 21870 Permit No. 17200

IN NAME OF

FRANK H. REEVES

Surveyed JUN. 11. 1947, by JAS. E. BUNNELL