


T.3S.R.3W.W.M.

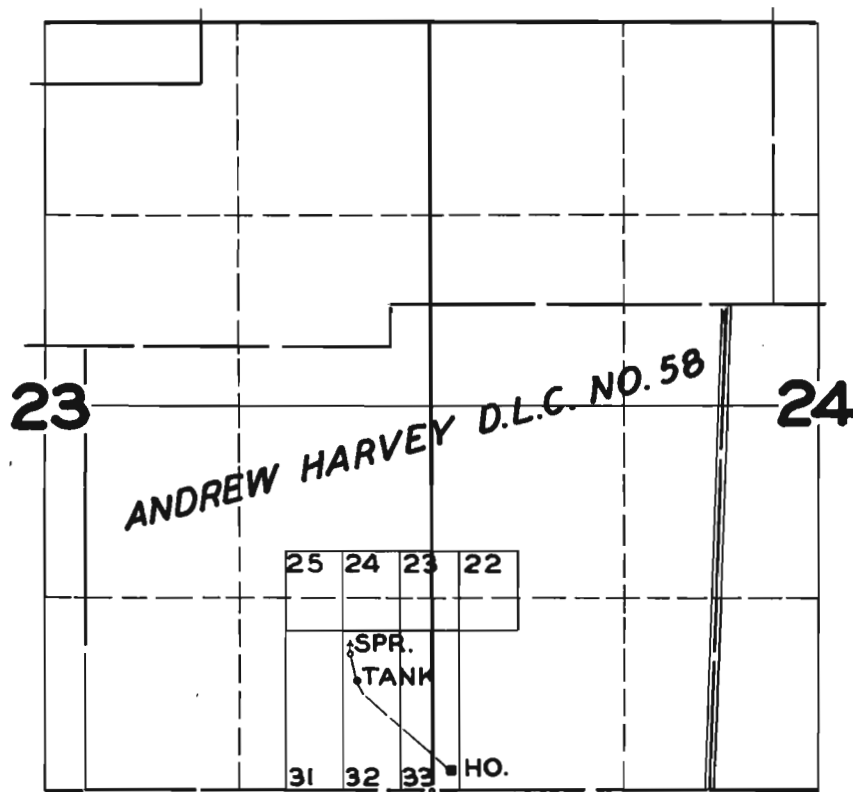

FINAL PROOF SURVEY

UNDER

Application No. 22378 Permit No. 17644

IN NAME OF

R. F. & MARIAN F. BIBBEE

Surveyed SEP. 8 1948, by JAS. E. BUNNELL