


# T.7S.R.3W.W.M.

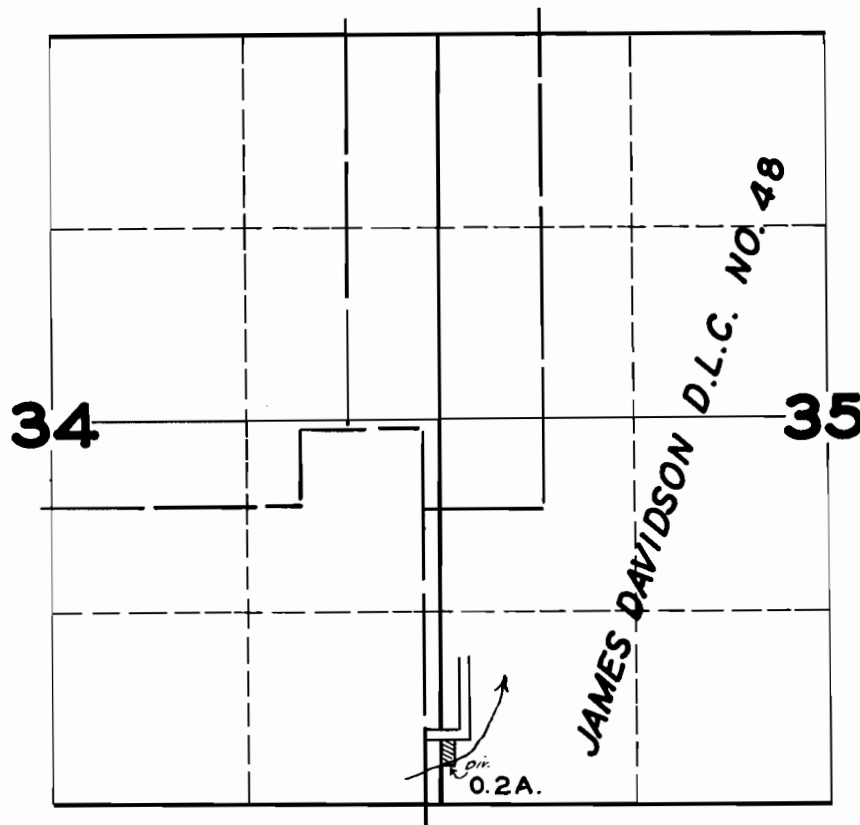

## FINAL PROOF SURVEY

UNDER

Application No. **22642** Permit No. **17798**

IN NAME OF

**C.M. GRAHAM**

Surveyed **SEP. 30** 1947, by **JAS. E. BUNNELL**