


T.30S.R.4W.W.M.

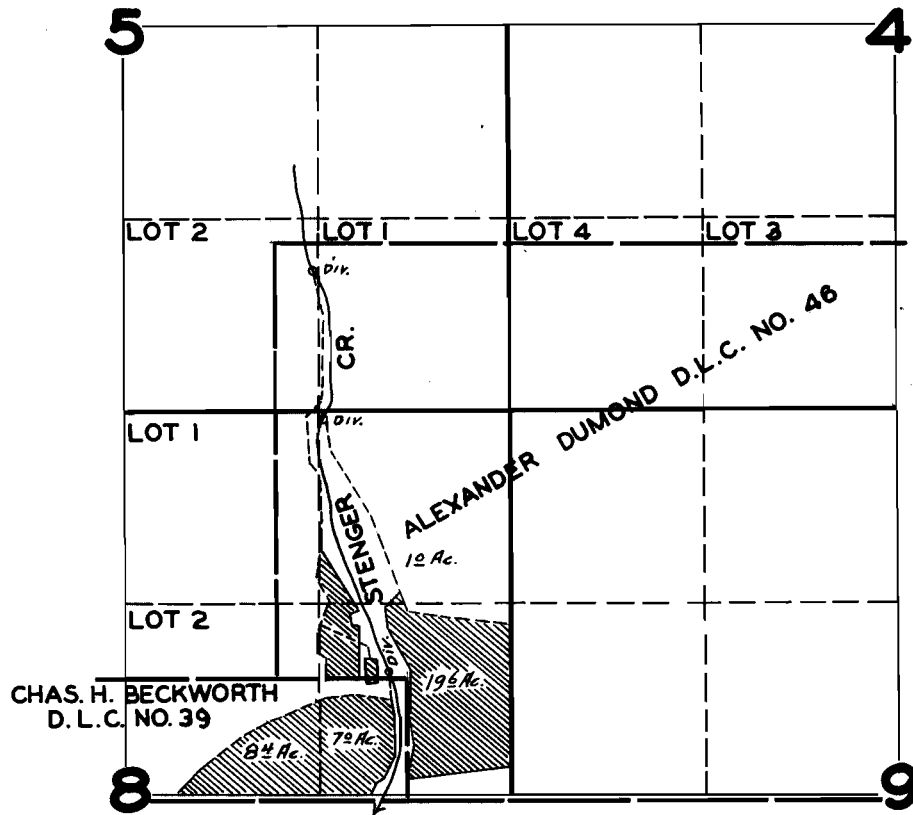

**FINAL PROOF SURVEY**

UNDER

Application No. 15606 Permit No. 11479

IN NAME OF

DONALD SNYDER

Surveyed JULY 9 1947, by JAS. E. BUNNELL