


T. IN. & IS. R. 2 W. W. M.

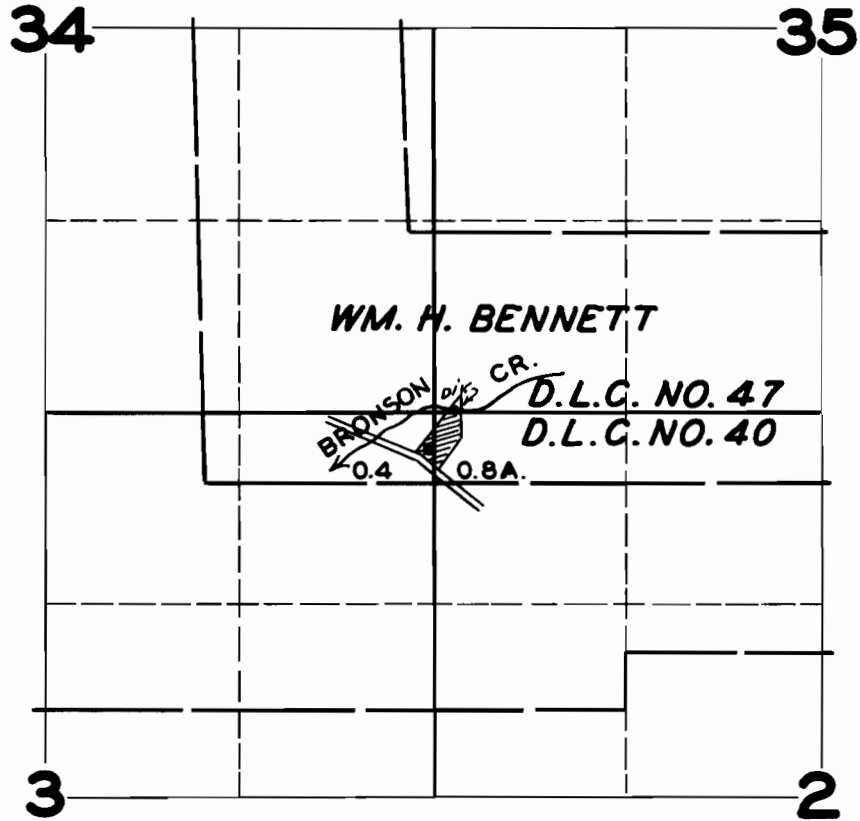

FINAL PROOF SURVEY

UNDER

Application No. 19291..... Permit No. 14917.....

IN NAME OF

M. LYNN JUDY

Surveyed MAY 5, 1948, by JAS. E. BUNNELL