


T.13&14S.R.17E.W.M.

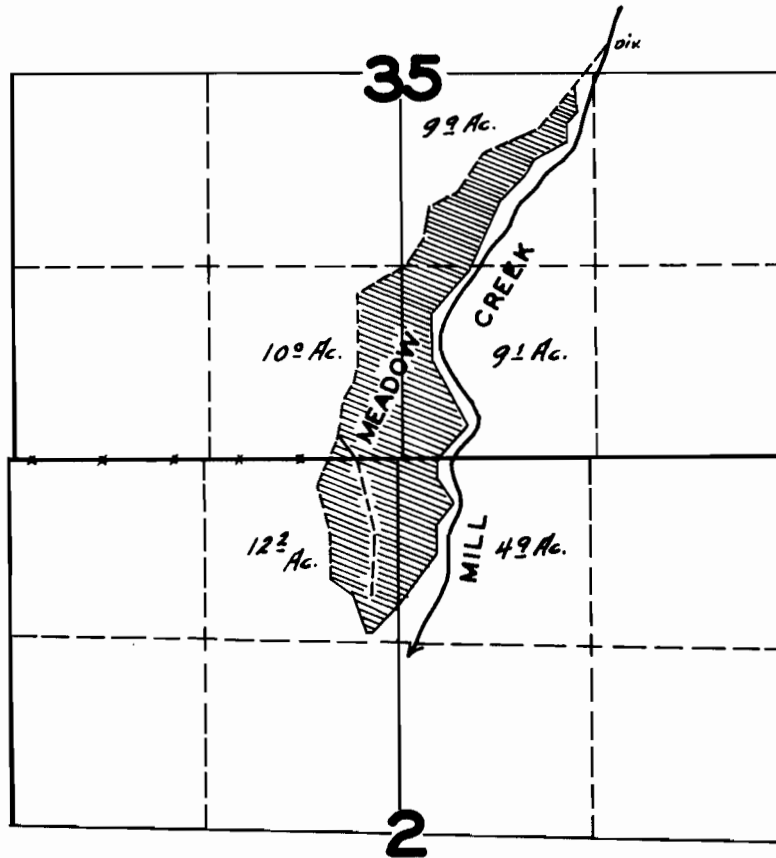

FINAL PROOF SURVEY
UNDER

Application No. 20036 Permit No. 15605

IN NAME OF

RAYMOND SMITH

Surveyed MAY 21 1947, by JAS. E. BUNNELL