


T.4S.R.10W.W.M.

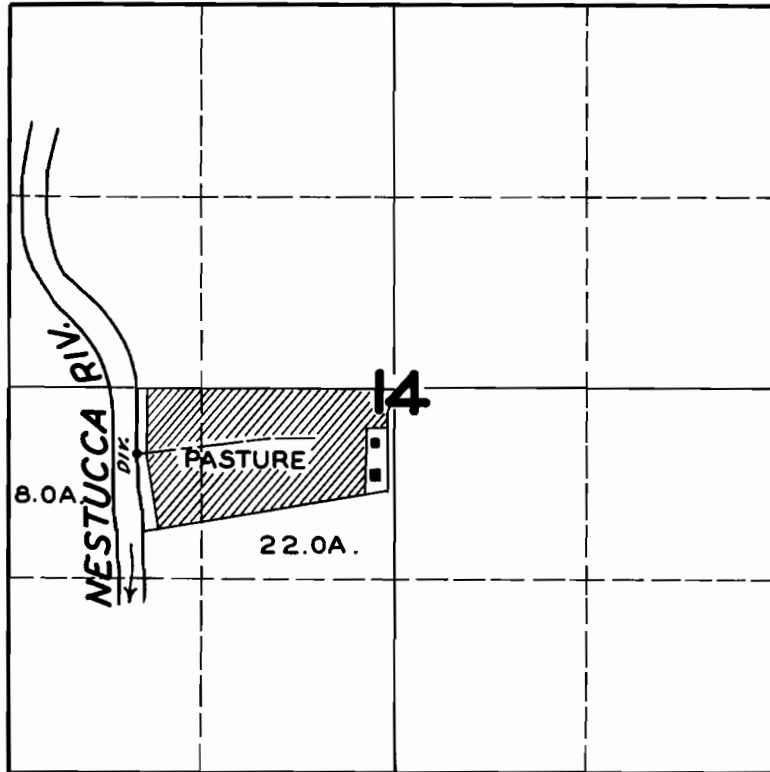

FINAL PROOF SURVEY UNDER

Application No. **20364** Permit No. **15931**
IN NAME OF

FRED WASSMER

Surveyed **SEP. 1** 1948, by **JAS. E. BUNNELL**