


T.5S.R.2E.W.M.

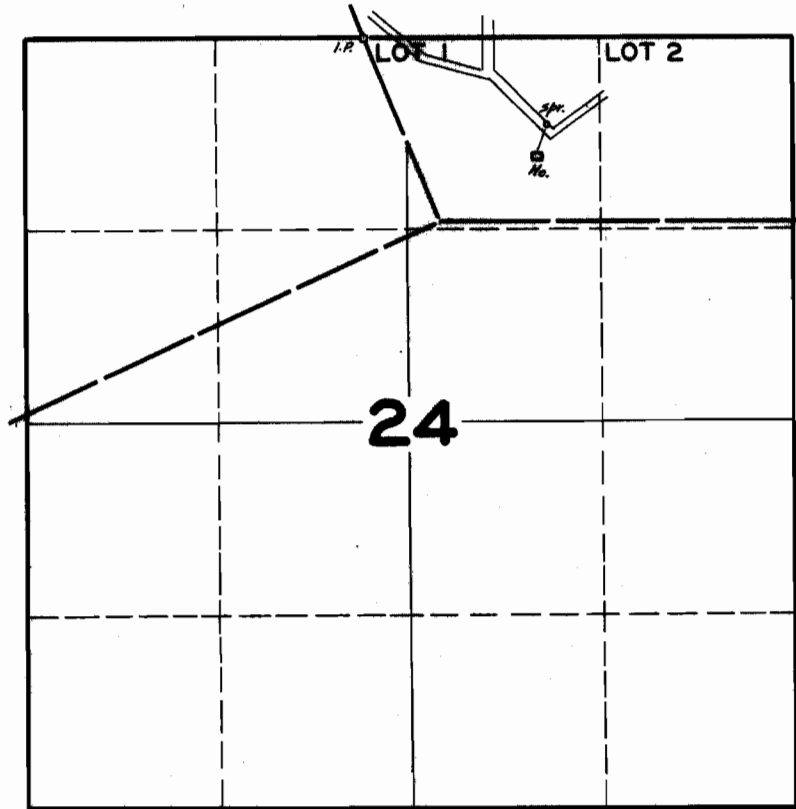

**FINAL PROOF SURVEY
UNDER**

Application No. 20938 Permit No. 16396

IN NAME OF

EDWIN WEIDMAN

Surveyed SEP. 3 1947, by JAS. E. BUNNELL