


T.41S, R.13W. W.M.

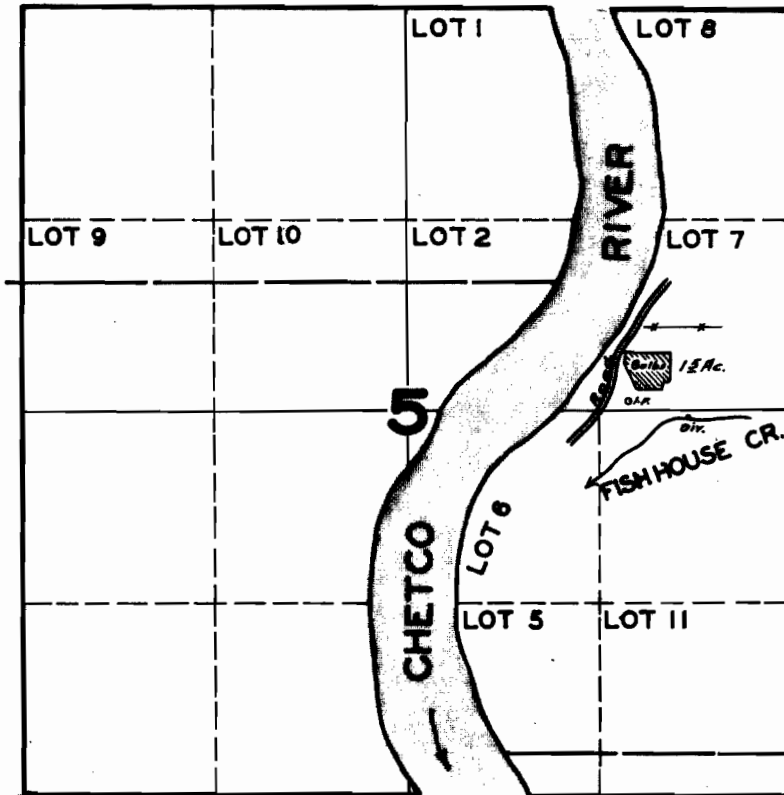

**FINAL PROOF SURVEY
UNDER**

Application No. 21233 Permit No. 16642

IN NAME OF

ROBERT A. CHILDERS

Surveyed JUL. 21, 1947, by JAS. E. BUNNELL