


T.3S.R.45E.W.M.

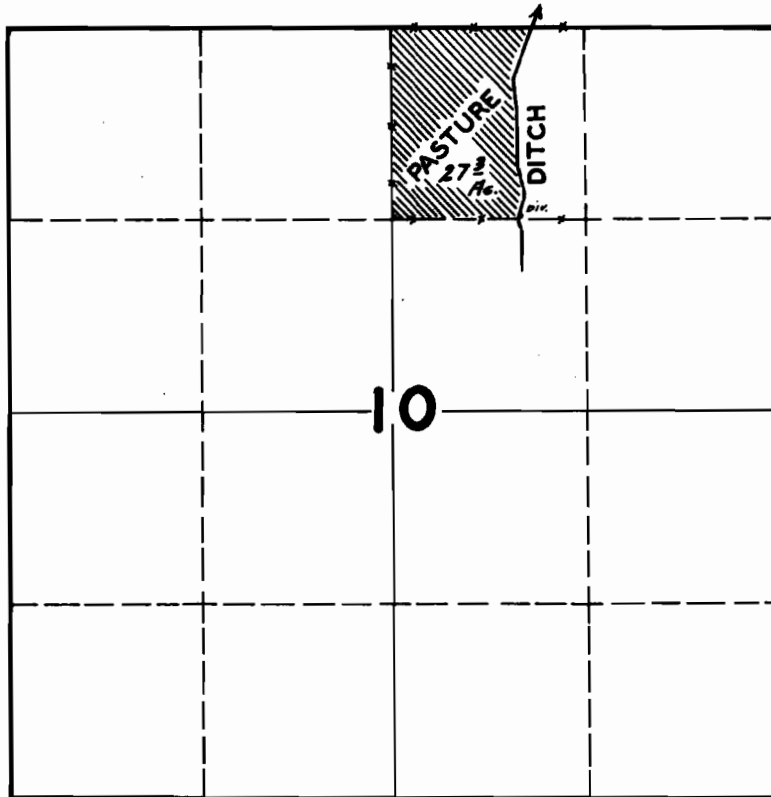

**FINAL PROOF SURVEY**  
UNDER

Application No. 21863 Permit No. 17195

IN NAME OF

ELMER McFETRIDGE

Surveyed MAY 13, 1947, by JAS. E. BUNNELL