


T.15S.R.4W.W.M.

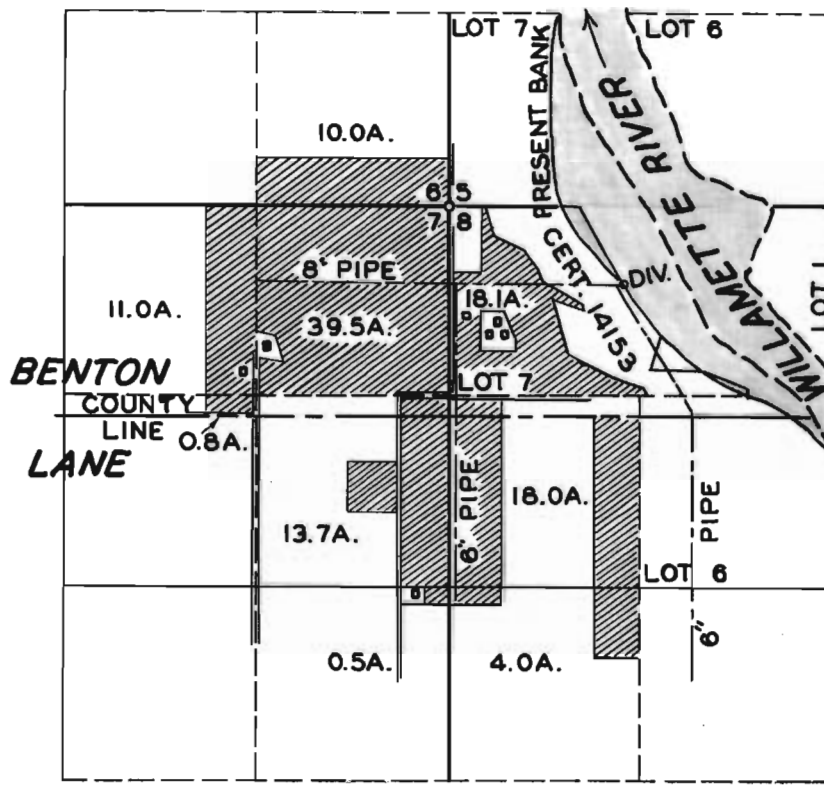

FINAL PROOF SURVEY

UNDER

Application No. 21394 Permit No. 17216

IN NAME OF

J. P. ADAMS & CARSON ADAMS

Surveyed JUNE 14, 1948, by JAS. E. BUNNELL