


T.3&4S.R.4&5W.W.M.

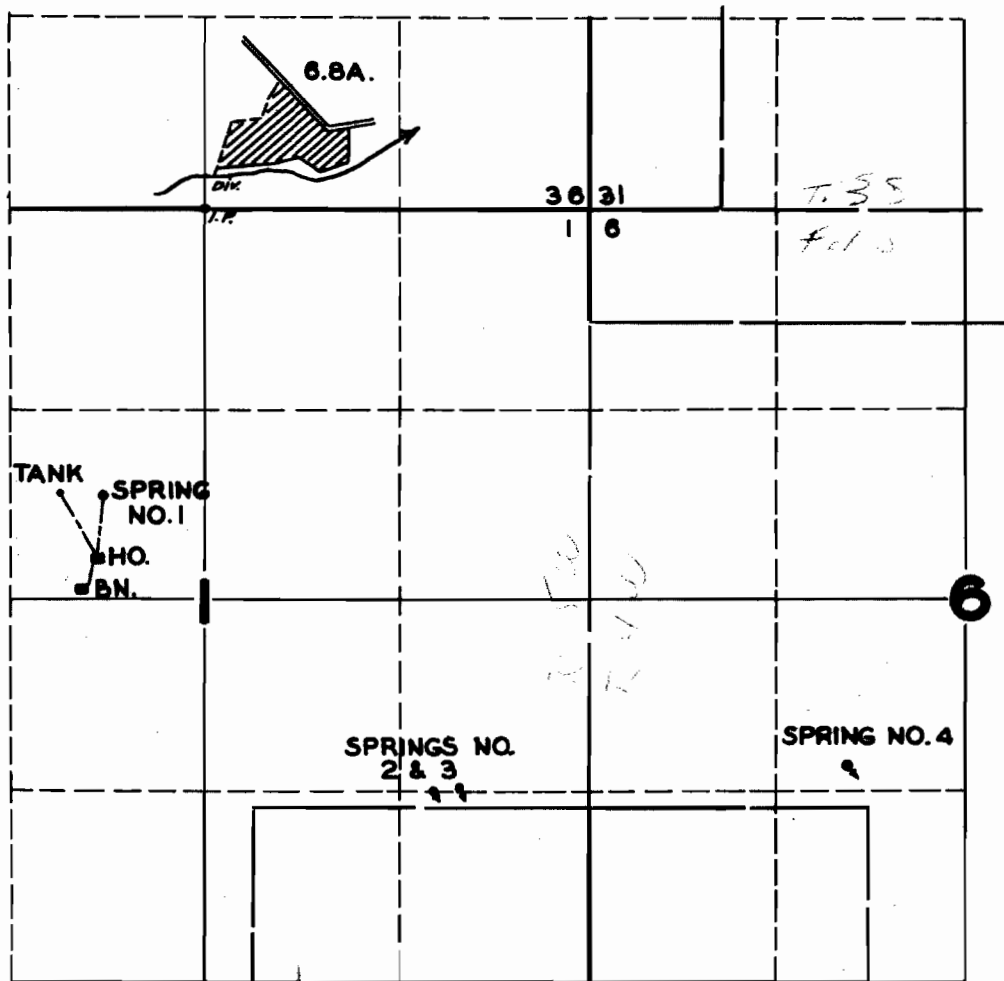

LOCATION OF SPRINGS ACCEPTED FROM APPLICANTS MAP

FINAL PROOF SURVEY UNDER

Application No. 14262 Permit No. 10300
IN NAME OF

LEON M. BERNSTEIN

Surveyed AUG. 26 1948, by JAS. E. BUNNELL