


T. 10S. R. 7W. W. M.

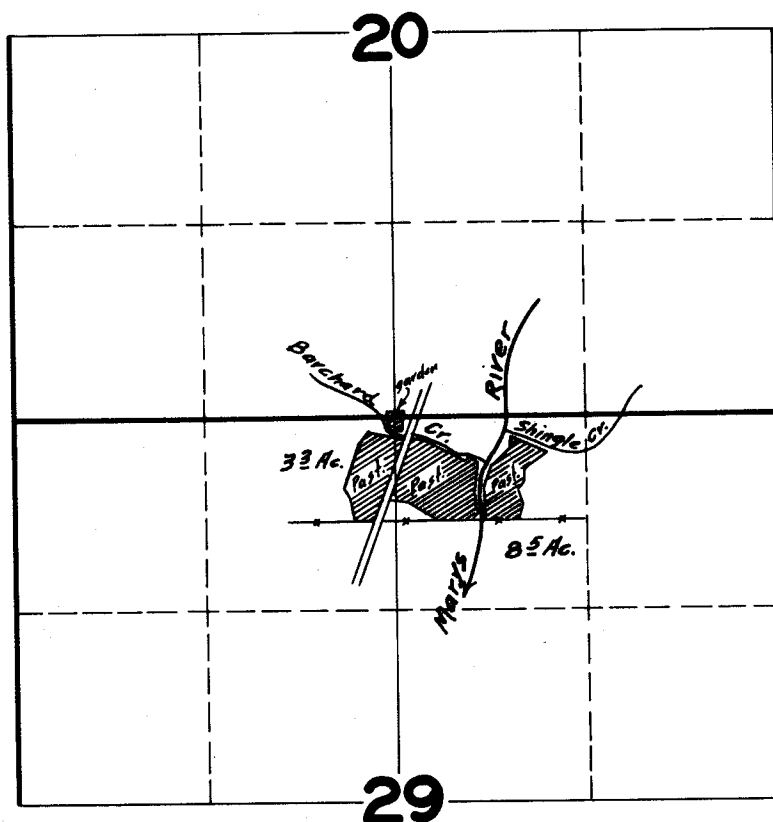

**FINAL PROOF SURVEY  
UNDER**

Application No. 17129 Permit No. 12853

IN NAME OF

F.M. DAY FOR L.L. DAY

Surveyed JUNE 30 1947, by JAS. E. BUNNELL