


T.11S.R.43E.W.M.

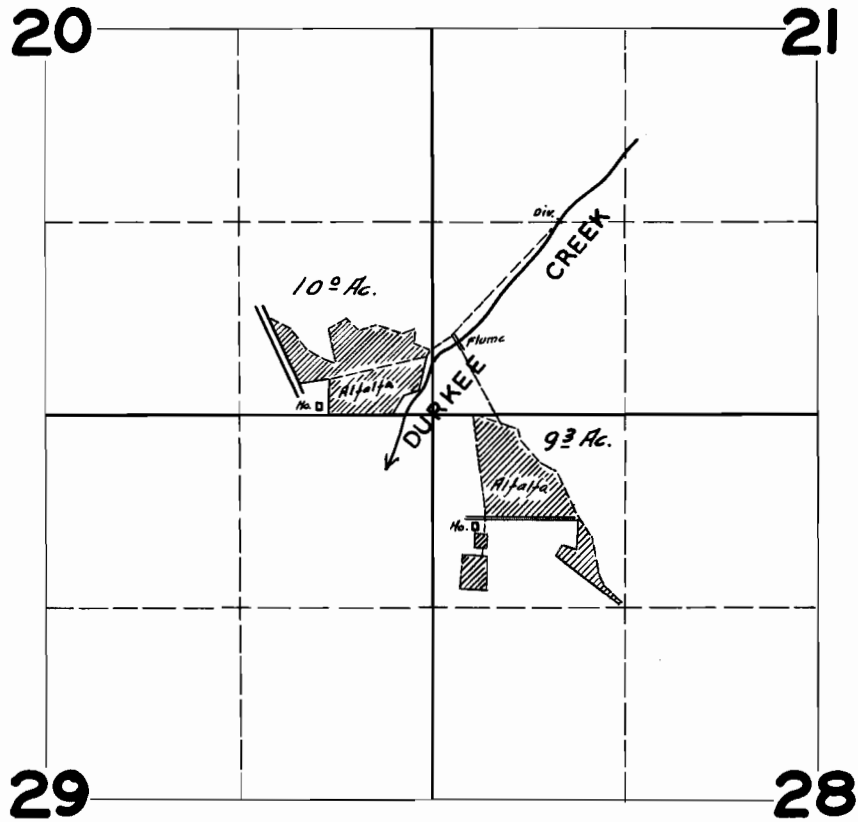

FINAL PROOF SURVEY UNDER

Application No. 17963 Permit No. 14233

IN NAME OF

M.M. GROGAN & ADER GROGAN

Surveyed MAY 16 1947, by JAS. E. BUNNELL