


# T.11S. R.43E. W.M.

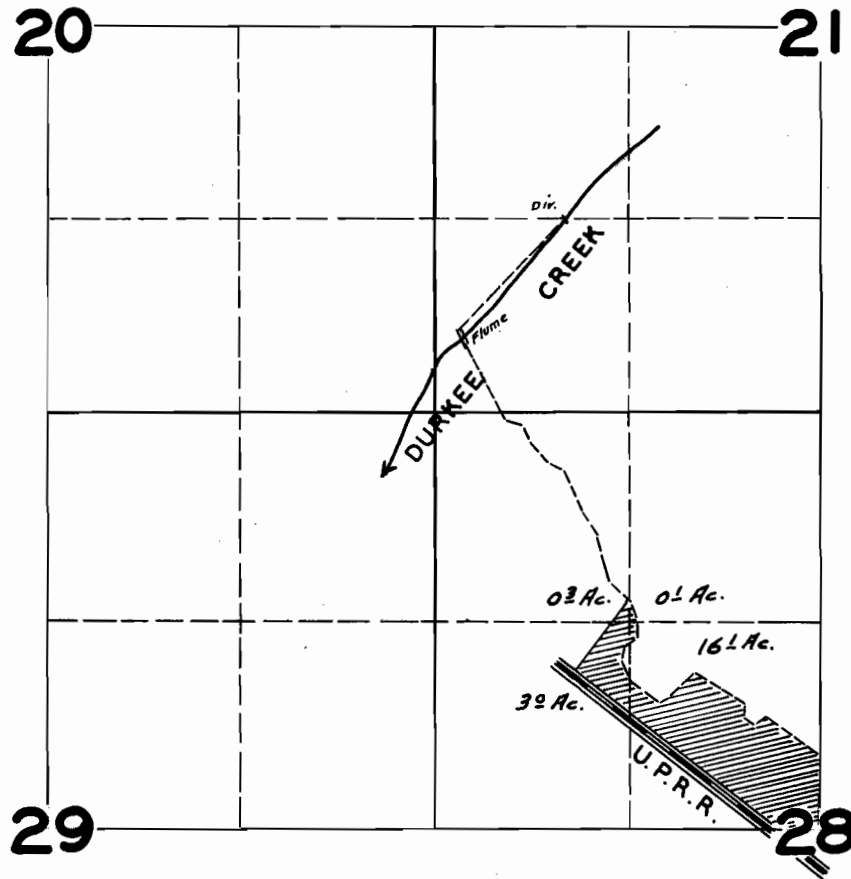

## FINAL PROOF SURVEY UNDER

Application No. 19876 Permit No. 15466

IN NAME OF

ADER GROGAN

Surveyed MAY 16 1947, by JAS. E. BUNNELL