


T.6S.R.1E.W.M.

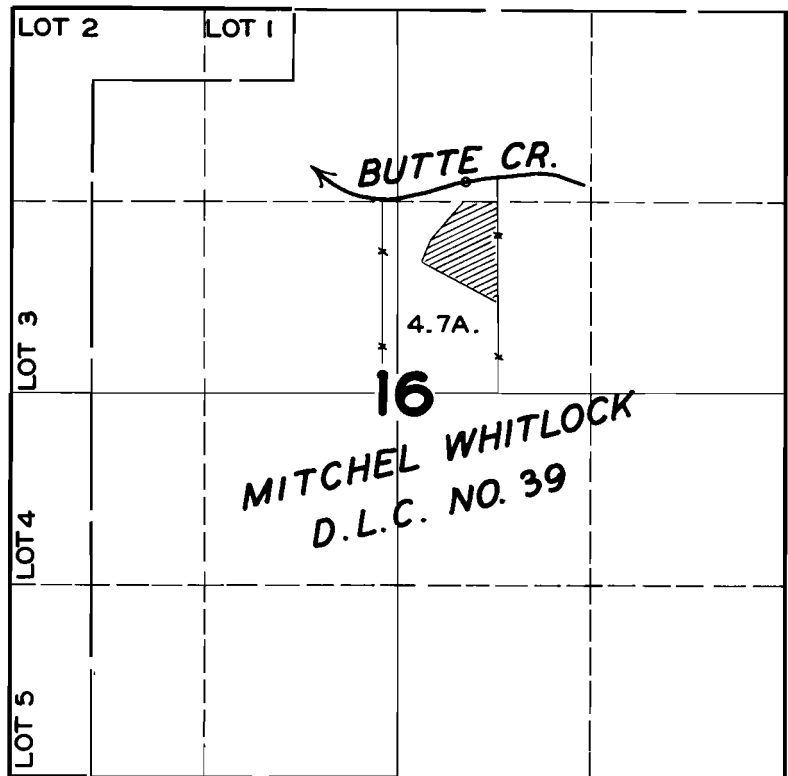

FINAL PROOF SURVEY UNDER

Application No. **19896** Permit No. **15475**
IN NAME OF

LAWRENCE MC CRACKEN

Surveyed **SEP. 30, 1948**, by **JAS. E. BUNNELL**