


T.3S.R.10W.W.M.

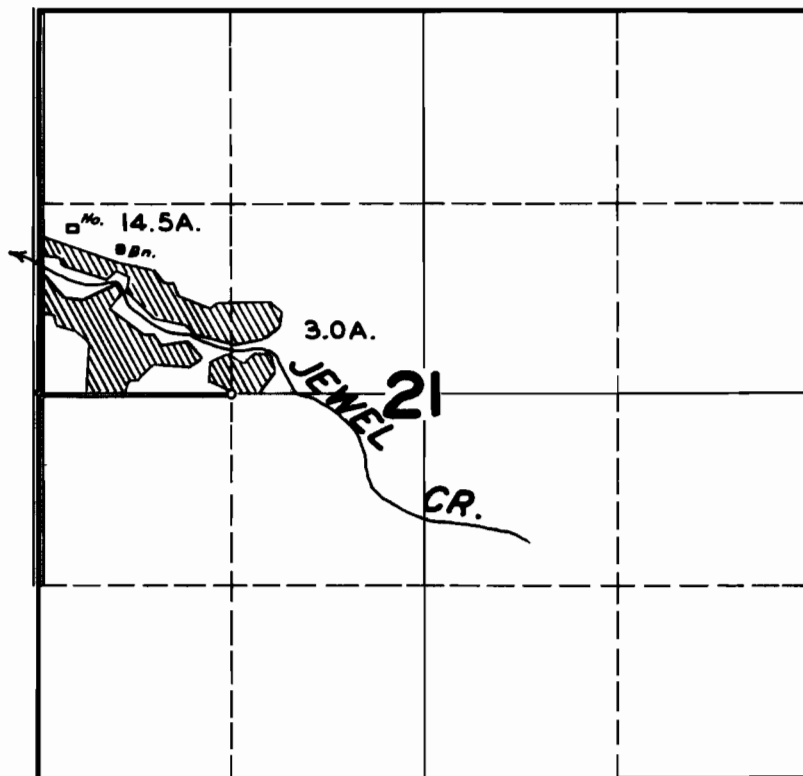

FINAL PROOF SURVEY
UNDER

Application No. **20425** Permit No. **15949**
IN NAME OF

HOWARD JOSEPH ROGERS

Surveyed **AUG. 31, 1948**, by **JAS. E. BUNNELL**