


T. 7S. R. 4W. W.M.

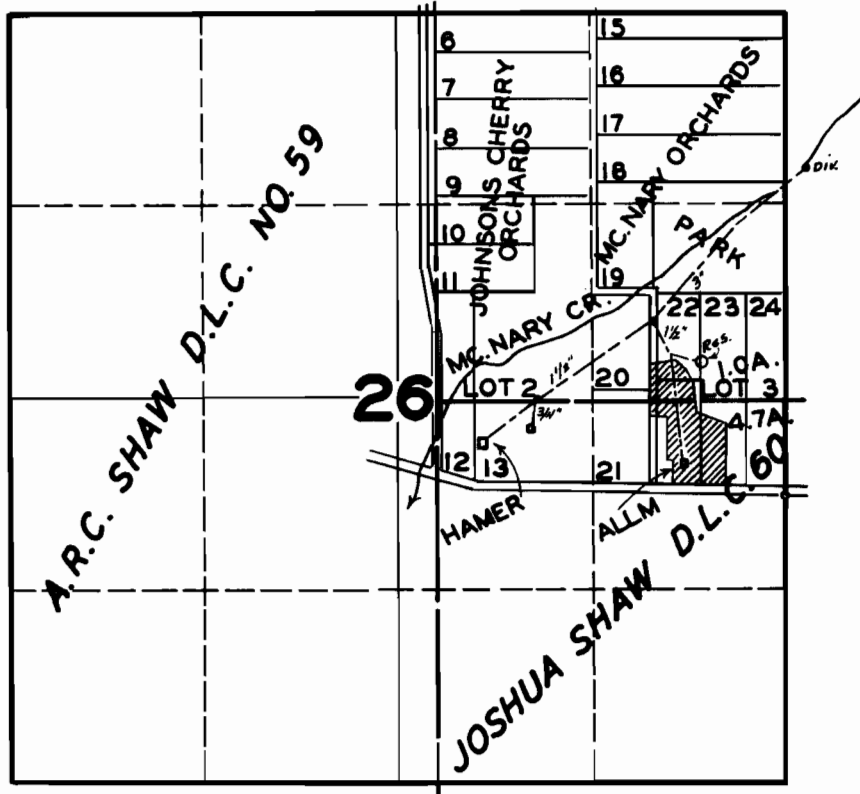

FINAL PROOF SURVEY UNDER

Application No. **20513** Permit No. **16015**
IN NAME OF

O. B. ALLM & E. T. HAMER

Surveyed **SEP. 15, 1947**, by **JAS. E. BUNNELL**