


T.6S.R.8W.W.M.

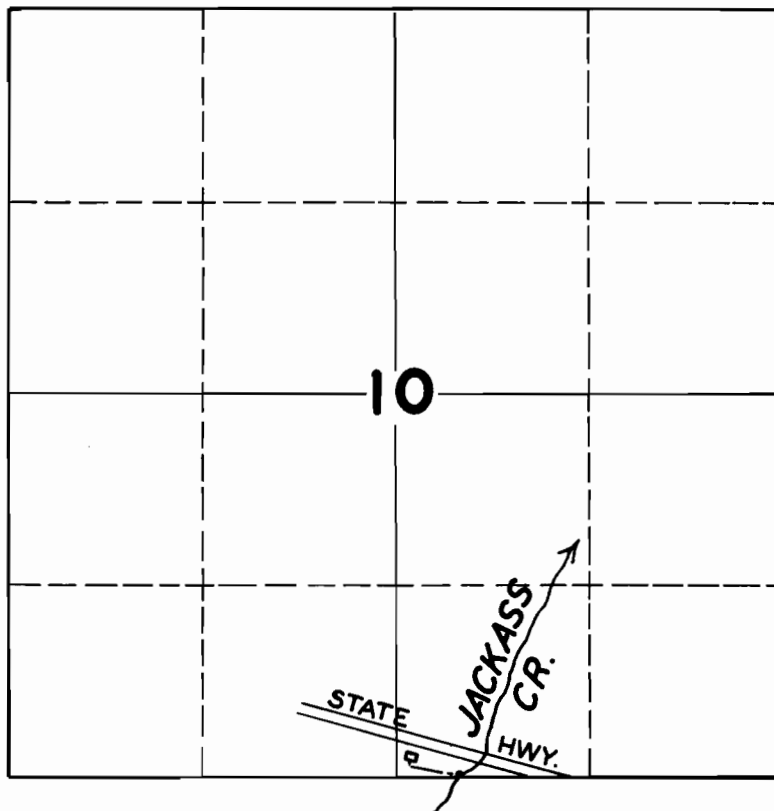

**FINAL PROOF SURVEY
UNDER**

Application No. **21074** ... Permit No. **16517**.....
IN NAME OF

LOUIS ANDERSON

Surveyed **MAR. 15 1949**, by **JAS. E. BUNNELL**