


T.5S.R.1W.W.M.

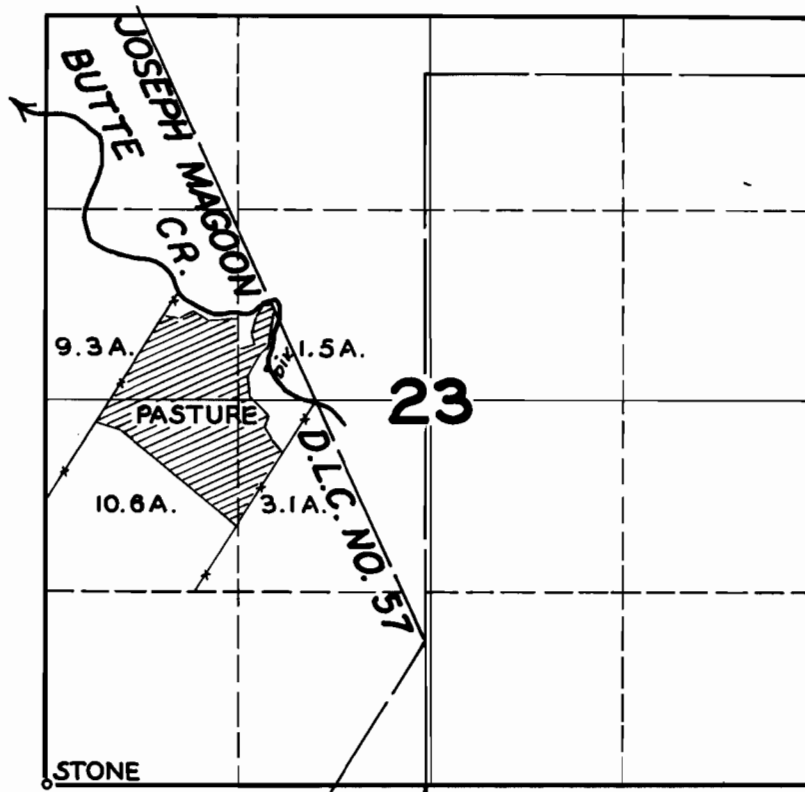

FINAL PROOF SURVEY

UNDER

Application No. 21421 Permit No. 16804

IN NAME OF

C. E. SKILLER

Surveyed APR. 29 1949, by JAS. E. BUNNELL