


T.28S.R.12W.W.M.

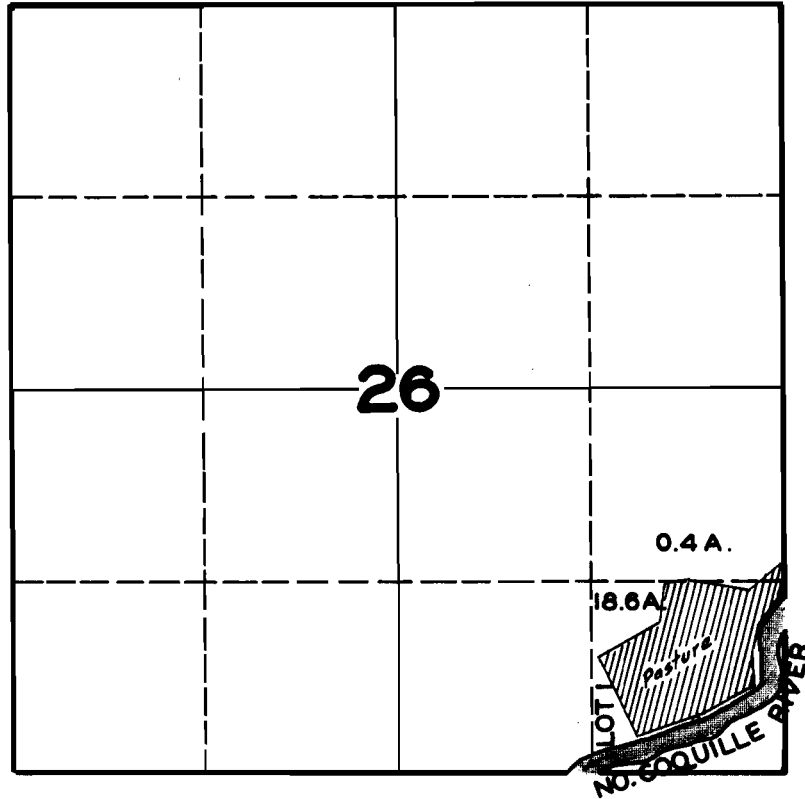

FINAL PROOF SURVEY
UNDER

Application No. **21666** Permit No. **17015**
IN NAME OF

CLARENCE E. MILLER

Surveyed **AUG. 20, 1947**, by **JAS. E. BUNNELL**