


T.4S.R.IW.W.M.

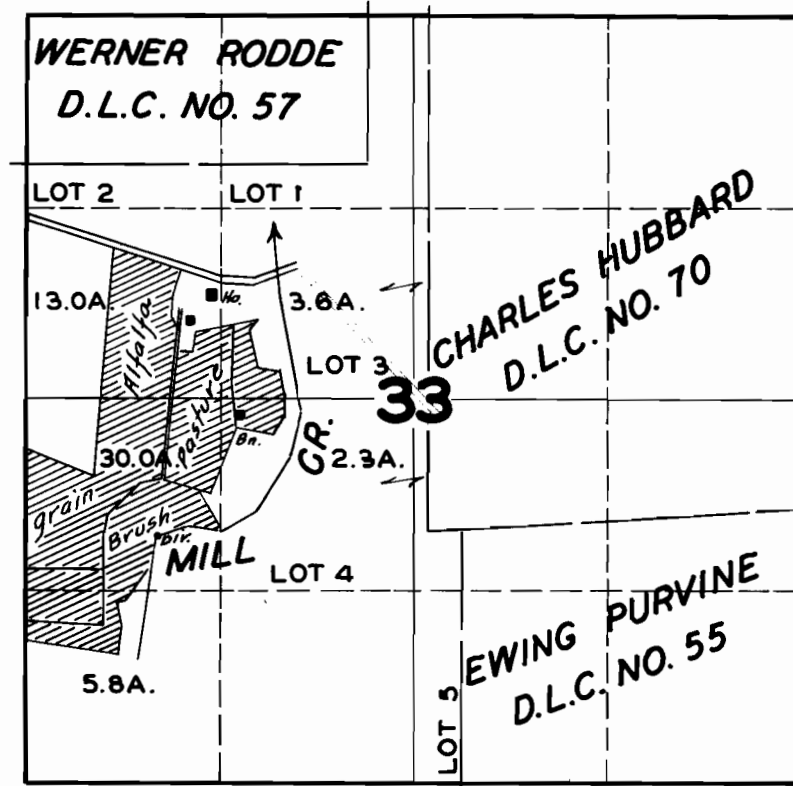

FINAL PROOF SURVEY

UNDER

Application No. **21864** Permit No. **17196**

IN NAME OF

JAMES L. HOPKINS

Surveyed **SEP. 10, 1948**, by **JAS. E. BUNNELL**