


X

T.14S.R.8W.W.M.

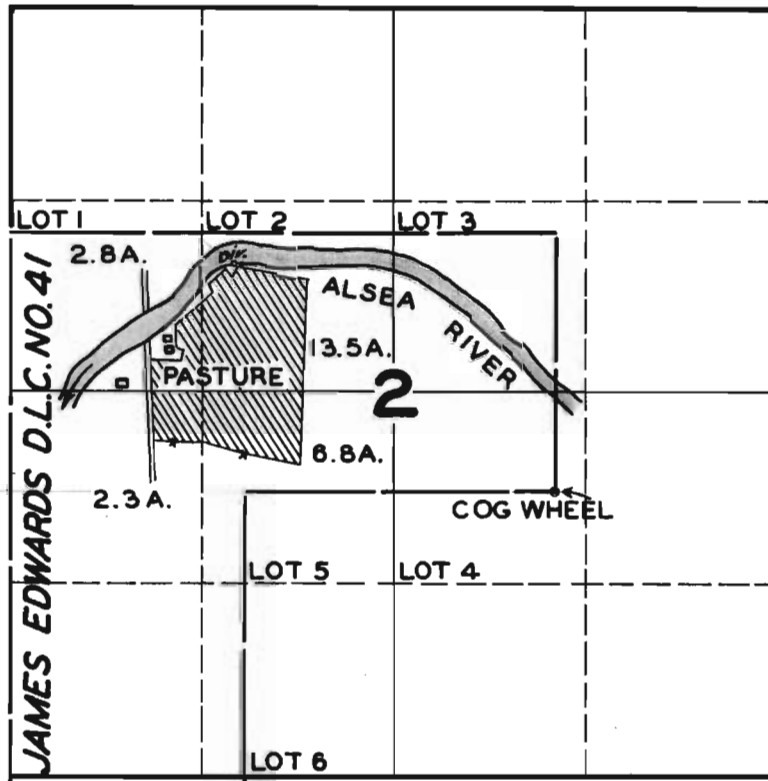

FINAL PROOF SURVEY UNDER

Application No. 19709 Permit No. 15285
IN NAME OF

H. L. HAYDEN

Surveyed JUNE 29 1947, by JAS. E. BUNNELL