


T.17S.R.1E.W.M.

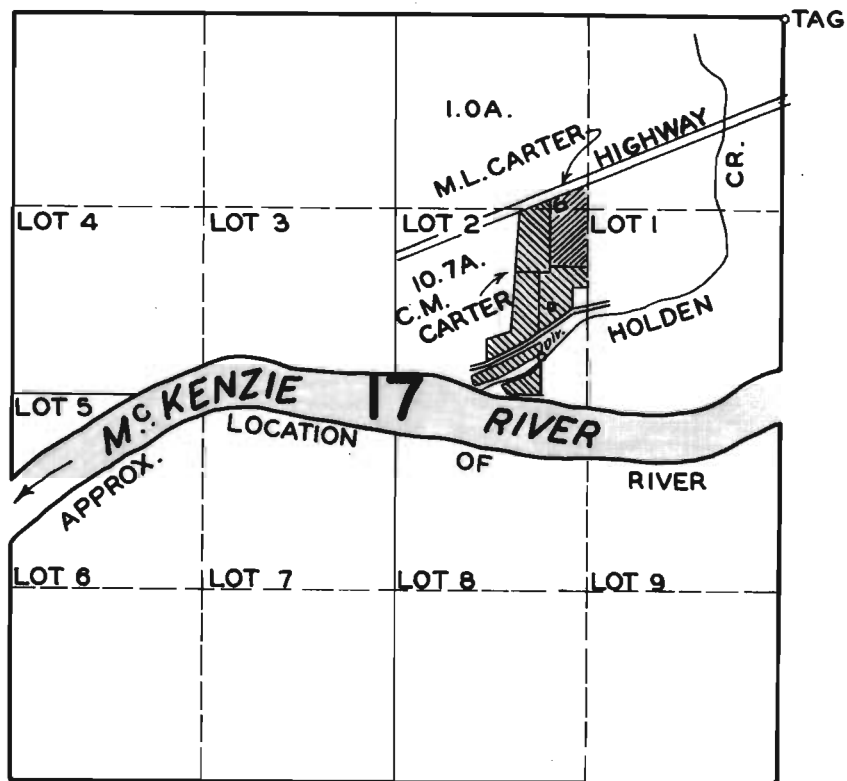

FINAL PROOF SURVEY
UNDER

Application No. **19778** Permit No. **15361**
IN NAME OF

CHARLIE M. & MELVIN L. CARTER

Surveyed **JUNE 16 1948**, by **JAS. E. BUNNELL**