


T. 1S. R. 4W. W.M.

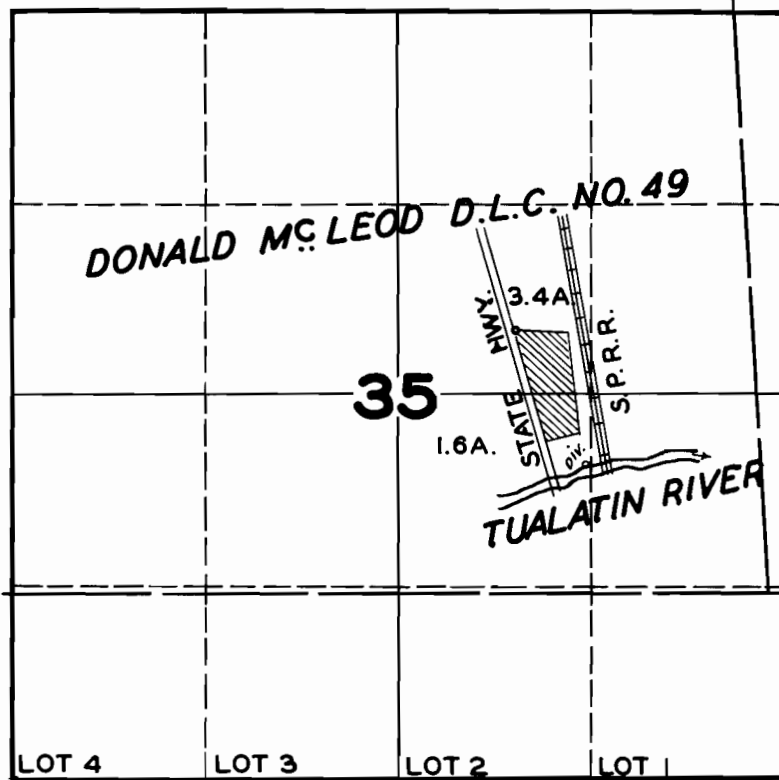

FINAL PROOF SURVEY
UNDER

Application No. 21093 Permit No. 16530
IN NAME OF

J. K. BURNS

Surveyed MAY 17 1948, by JAS. E. BUNNELL