


T.5S.R.3W.W.M.

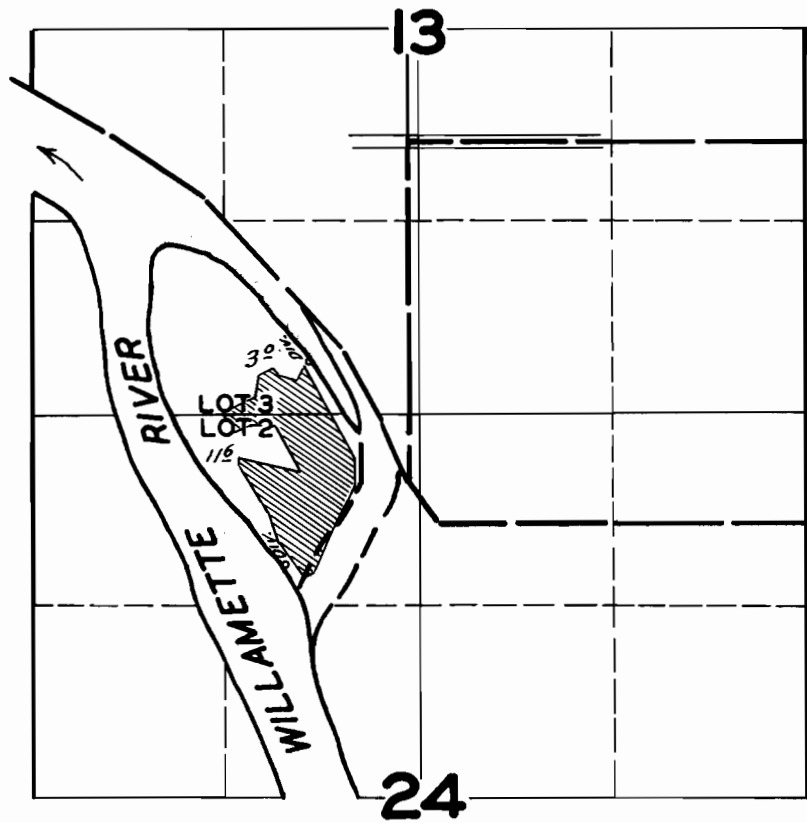

**FINAL PROOF SURVEY
UNDER**

Application No. 19098 Permit No. 14705

IN NAME OF

MICHAEL J. MAHONY

Surveyed AUG. 1, 1947, by JAS. E. BUNNELL