


T.14S. R. 8W.W.M.

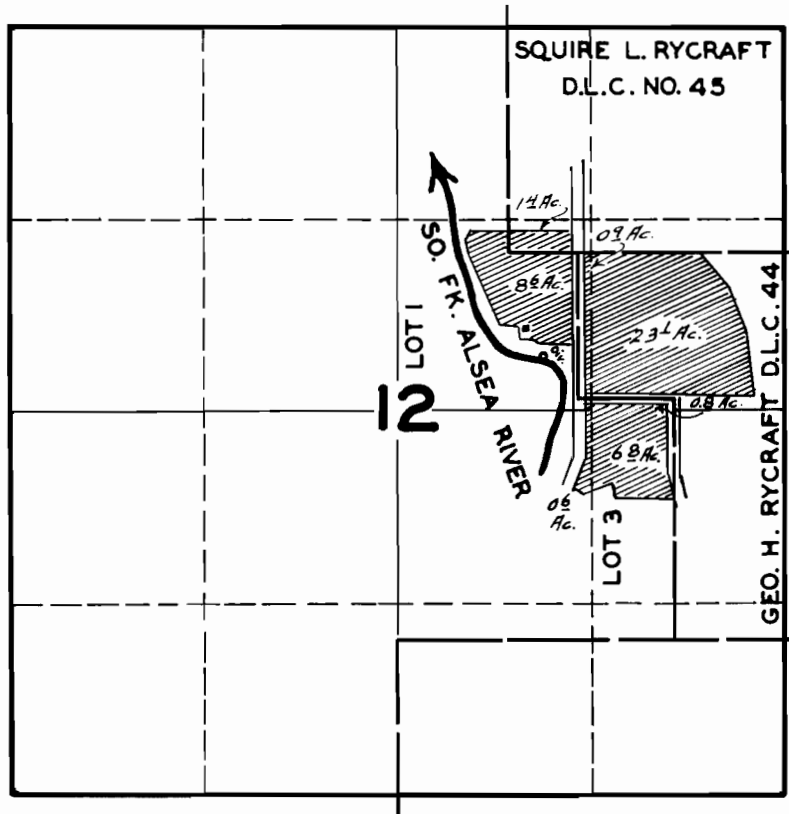

FINAL PROOF SURVEY UNDER

Application No. 19219 Permit No. 14848

IN NAME OF
BENNIE WREN

Surveyed JUL. 14, 1947, by JAS. E. BUNNELL