


T.13S.R.3W.W.M.

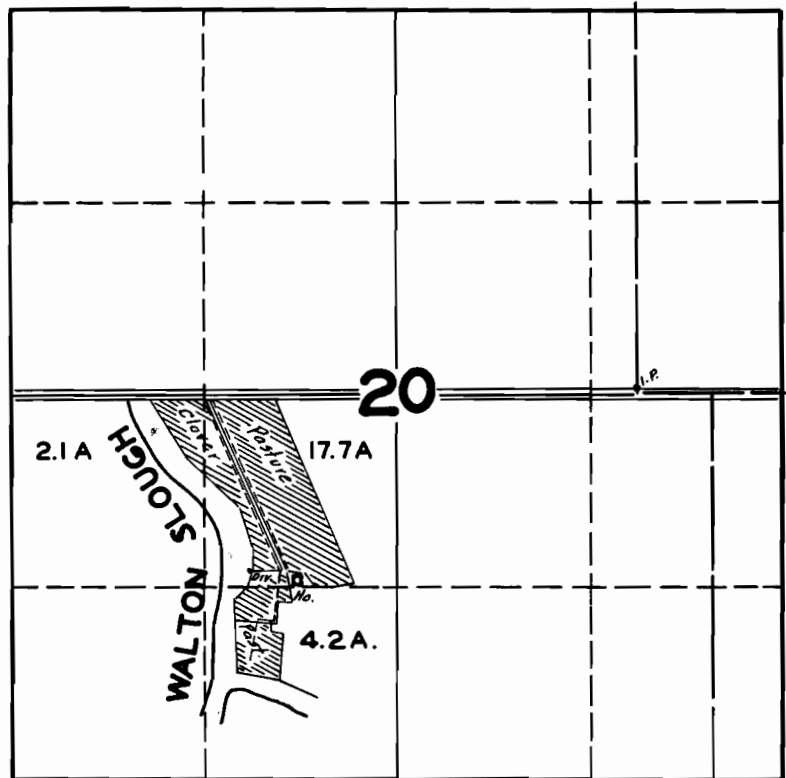

FINAL PROOF SURVEY

UNDER

Application No. 19110 Permit No. 14715

IN NAME OF

REX DICK

Survived MAY 7 1947, by JAS. E. BUNNELL