


# T.I.S.R.I.E.W.M.

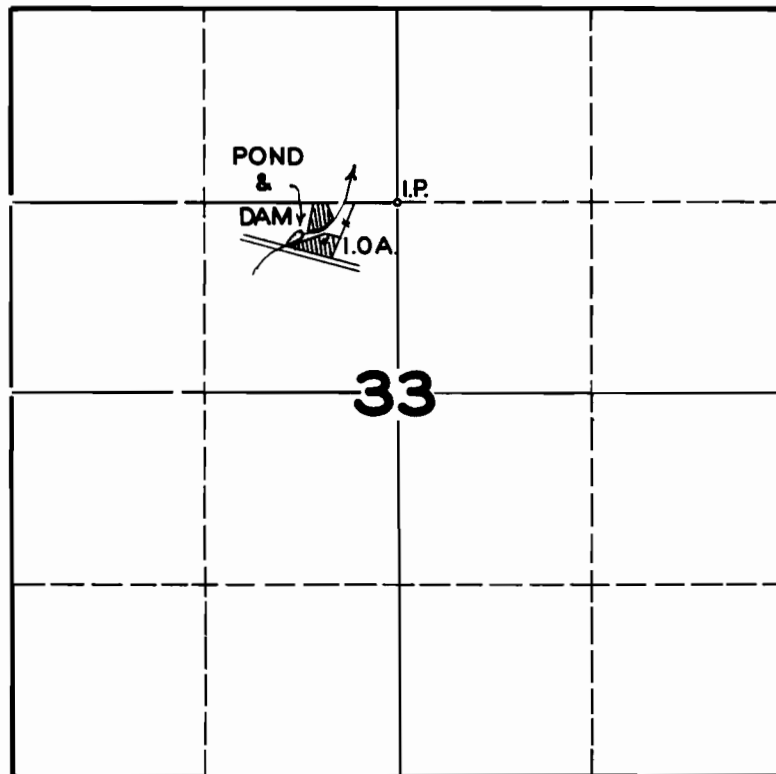

## FINAL PROOF SURVEY UNDER

Application No. 19274... Permit No. 14868...  
IN NAME OF

HARRY B. ALTMAN

Surveyed MAY 13, 1948, by JAS. E. BUNNELL