


# T.17S.R.21E.W.M.

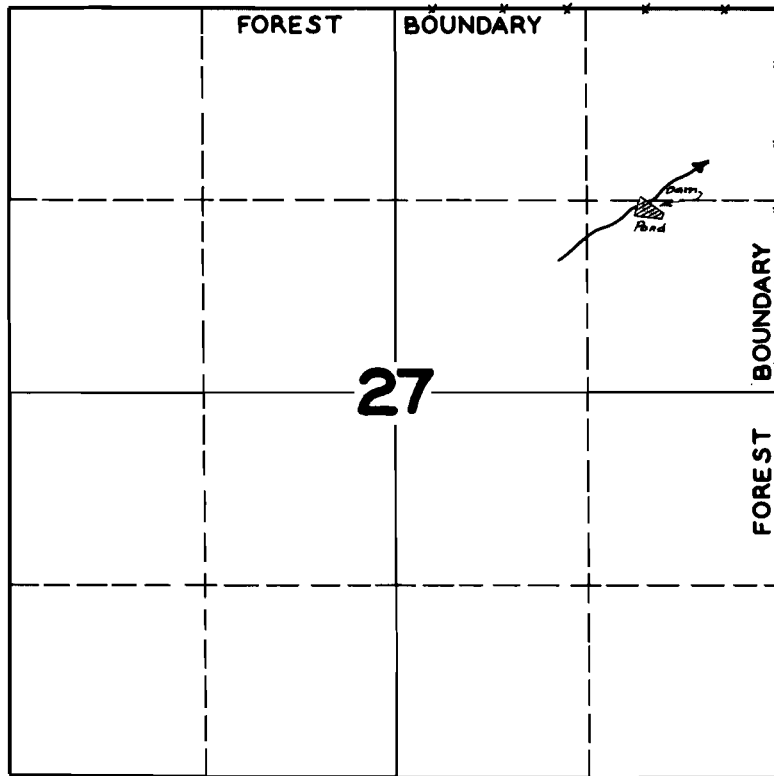

## FINAL PROOF SURVEY

UNDER

R-19330

R-764


Application No. 19331 Permit No. 4923

IN NAME OF

U.S.A. DEPT. OF AGRI. FOREST SERVICE

Surveyed MAY 22 1947, by JAS. E. BUNNELL

# T.17S.R.21E.W.M.

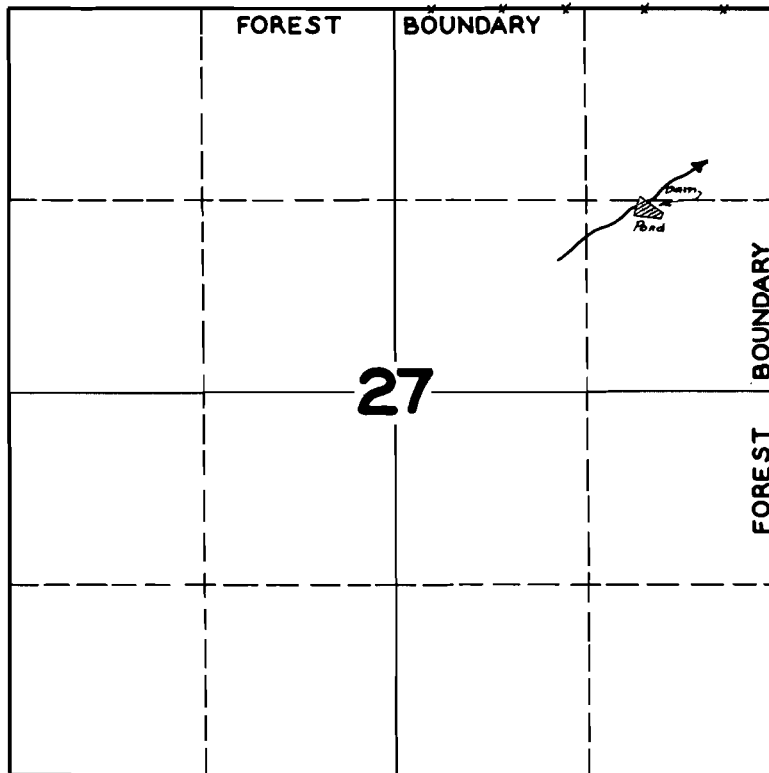

## FINAL PROOF SURVEY

UNDER

R-19330

R-764

Application No. 19331 Permit No. 14923

IN NAME OF

U.S.A. DEPT. OF AGRIC. FOREST SERVICE

Surveyed MAY 22 1947, by JAS. E. BUNNELL