


T.2S.R.3W.W.M.

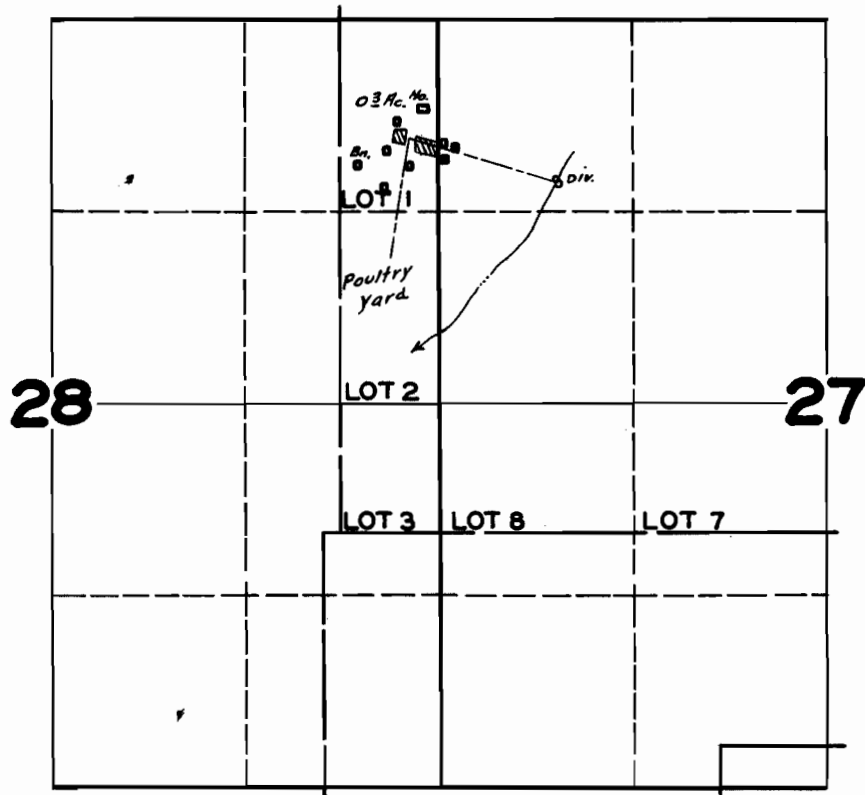

FINAL PROOF SURVEY UNDER

Application No. 19432... Permit No. 15031...
IN NAME OF

.....MRS. HILLIE TYKESON.....

Surveyed APR. 4... 1947., by JAS. E. BUNNELL